
, IEH ,	ELL Fracti	ion				Section Number	Townst	nip Numbe		Range Nun	nber
na de	N1	1/4	NE	1/4 SW	1/4	29	т 3	2	s	R 30	E
and direction from	nearest town or ci	ty? From	theSE	Corner	Street	address of well it	f located within	n city?			
Plains 1 k											
WA - 3 WELL OWNER:		Bender	and E	. Genea	1 Bende	T					_
#, St. Address, Box # y, State, ZIP Code		70 £ 79 £	•					-	ture, Divisionber: 1394	_	Resou
DEPTH OF COMPLETE		4 D	oro Holo F	liamatar	26	in to					
ell Water to be used as:		lic water s		nameter		onditioning		11 Injectio		•	
1 Domestic 3 Feedlo		field water			9 Dew	•		•	Specify belo	w)	
	ial 7 Law					ervation well		,	· · · · · · · · · · · · · · · ·	•	
ell's static water level	205 ft. I	below land	surface n	neasured on	Apri	L m					y
imp Test Data	: Well wa	ter was	241				. hours pump	ing	1550		g
t. Yield 1900	gpm: Well wa	ter was	264	ft. after	· 3		hours pump	ing	1900		9
TYPE OF BLANK CASH			5 Wroug	ht iron	8 Cc	ncrete tile	Cas	ing Joints:			
	3 RMP (SR)			tos-Cement	9 Ot	her (specify belo	w)		Welded		
2 PVC	4 ABS		7 Fiberg						Threaded.		
ank casing dia16											
sing height above land s			in., '	weight				_	•	417	
PE OF SCREEN OR PE			c ====	lass		PVC) Asbestos			
1 Steel 2 Brass	3 Stainless steel 4 Galvanized stee		5 Fiberg 6 Concre			8 RMP (SR)			ecify)		
reen or Perforation Open		5 1	o Concr		9 zed wrappe			12 None used (op Saw cut		le) lone (open	hole)
	Mill slot				zed wrappe wrapped		9 Drilled h		11 1	ione (open	noie)
				7 Torci		• •		Other (specify)			
reen-Perforation Dia			5 . ft								
reen-Perforated Intervals:											
	****** 360-4	420 Sc1	Ceent X	420-42	5 Perf	ft., From			. to		
avel Pack Intervals:						ft., From					
	From		ft. to						. to		
			2 Cement	grout	3 B	entonite 4	Other				
GROUT MATERIAL:	 Neat cement 								4	. to	
			ft.	, From		ft. to	ft. , F	rom	11		
routed Intervals: From	. 0 ft. to	10	ft.	, From			ft., F storage		14 Abando	ned water v	well























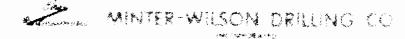

H. Carol Bender Meade County March 17, 1982

Location: SW2 29-32-30 West side of Plains 2 South, & West, North, 200' West Static Water Level - 204 Test # 0 1 Top Soil 1 61 Brown Clay 61 98 Medium to Coarse Gravel (Loose) 98 110 Brown Clay 121 110 Clay & Sand 191 Fine to Medium Sand & Gravel (Loose) 10% Clay 121 191 200 Brown Clay 200 221 Fine to Medium Sand & Fine Gravel 10% Clay (Loose) 221 230 Brown Clay 230 260 Blue Clay 280 260 Fine to Medium Sand & Fine Gravel 20% Clay Fine to Medium Sand & Gravel (Loose) 280 293 293 296 Brown Clay 296 304 Fine to Medium Sand & Gravel 10% Clay (Loose) 304 310 Fine to Medium Sand & Gravel 20% Clay 310 333 Fine to Medium Sand & Gravel 10% Clay (Loose) 333 350 Fine to Coarse Sand & Fine Gravel 30% Clay 350 366 Fine to Coarse Sand 20% Clay (Fairly Loose) 366 421 Fine to Medium Sand & Gravel 10% Clay (Loose) Some Coarse Gravel 430 Brown Clay 421

Brown & Gray Clay (Tight)

Gray Yellow Clay & Shale (Hard)

430

479

479

485