

WATER WELL RECORD


Form WWC-5

Division of Water Resources App. No.

1 LOCATION OF WATER WELL: County: Meade Fraction 1/4 NW 1/4 NW 1/4 SW 1/4 Section Number 20 Township No. T 32 S Range Number R 30 E NW

Street/Rural Address of Well Location; if unknown, distance & direction from nearest town or intersection: 1 mile west of Plains Global Positioning System (GPS) information: Latitude: Longitude: Elevation: Datum: Collection Method: GPS unit: Digital Map/Photo: Topographic Map: Land Survey: Est. Accuracy:

2 WATER WELL OWNER: RR#, Street Address, Box #: Layne Angell Box 249 City, State, ZIP Code: Plains, KS 67869

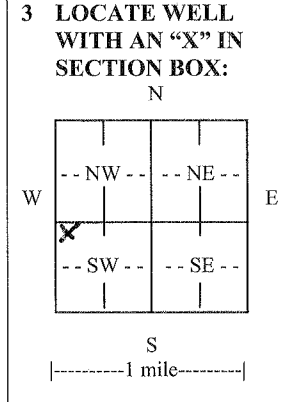

4 DEPTH OF COMPLETED WELL: 506 ft. Depth(s) Groundwater Encountered (1) 291 ft. (2) ft. (3) ft. WELL'S STATIC WATER LEVEL: 291 ft. below land surface measured on mo/day/yr. Pump test data: Well water was ft. after hours pumping gpm EST. YIELD: 50 gpm Well water was ft. after hours pumping gpm Bore Hole Diameter 9 1/4 in. to ft. and in. to ft. WELL WATER TO BE USED AS: Domestic, Feedlot, Oil field water supply, Dewatering, Other (Specify below) Irrigation, Industrial, Domestic-lawn & garden, Monitoring well Was a chemical/bacteriological sample submitted to Department? Yes No If yes, mo/day/yr sample was submitted. Water well disinfected? Yes No

5 TYPE OF CASING USED: Steel PVC Other CASING JOINTS: Glued Clamped Welded Threaded Casing diameter 5 in. to 1.46 ft., Diameter in. to ft., Diameter in. to ft. Casing height above land surface 12 in., Weight lbs./ft., Wall thickness or gauge No. #200 TYPE OF SCREEN OR PERFORATION MATERIAL: Steel Stainless Steel PVC Other (Specify) Brass Galvanized Steel None used (open hole) SCREEN OR PERFORATION OPENINGS ARE: Continuous slot Mill slot Gauze wrapped Torch cut Drilled holes None (open hole) Louvered shutter Key punched Wire wrapped Saw cut Other (specify) SCREEN-PERFORATED INTERVALS: From 446 ft. to 506 ft., From ft. to ft. From ft. to ft., From ft. to ft. GRAVEL PACK INTERVALS: From 250 ft. to 506 ft., From ft. to ft. From ft. to ft., From ft. to ft.

6 GROUT MATERIAL: Neat cement Cement grout Bentonite Other Grout Intervals: From 245 ft. to 25 ft., From 5 ft. to 25 ft., From ft. to ft. What is the nearest source of possible contamination: Septic tank Lateral lines Pit privy Livestock pens Insecticide storage Other (specify below) Sewer lines Cesspool Sewage lagoon Fuel storage Abandoned water well Watertight sewer lines Seepage pit Feedyard Fertilizer storage Oil well/gas well Direction from well Southwest Distance from well 125'

Table with columns: FROM, TO, LITHOLOGIC LOG, FROM, TO, LITHO. LOG (cont.) or PLUGGING INTERVALS. Rows include soil types like Topsoil, Sandy Clay, Fine to Med Sand, Med Sand w/ Yellow Clay Strands, Clay & Fine Sand, Fine to Med Sand, Med Sand w/ Clay Layers, Sugar Sand w/ Sandstone Layers.

7 CONTRACTOR'S OR LANDOWNER'S CERTIFICATION: This water well was constructed, reconstructed, or plugged under my jurisdiction and was completed on (mo/day/year) 11-30-12 and this record is true to the best of my knowledge and belief. Kansas Water Well Contractor's License No. 305 (This Water Well Record was completed on (mo/day/year) 12-7-12 under the business name of Southwest Windmill by (signature) [Signature]

INSTRUCTIONS: Use typewriter or ball point pen. PLEASE PRESS FIRMLY and PRINT clearly. Please fill in blanks and check the correct answers. Send three copies (white, blue, pink) to Kansas Department of Health and Environment, Bureau of Water, Geology Section, 1000 SW Jackson St., Suite 420, Topeka, Kansas 66612-1367. Telephone 785-296-5524. Send one copy to WATER WELL OWNER and retain one for your records. Include fee of \$5.00 for each constructed well. Visit us at http://www.kdheks.gov/waterwell/index.html.