

WATER WELL PLUGGING RECORD Form WWC-5P

KSA 82a-1212 ID NO.

MW-201

1 LOCATION OF WATER WELL: Fraction SW 1/4 SE 1/4 NW 1/4 SE 1/4 Section Number 16 Township Number T 32 S Range Number 30 E W
 County: Meade


Street/Rural Address of Well Location; if unknown, distance & direction from nearest town or intersection: If at owner's address, check here 304 Grand Avenue, Plains, Ks.

Global Positioning Systems (GPS) information:
 Latitude: 37.2608 (in decimal degrees)
 Longitude: 100.5865 (in decimal degrees)
 Elevation: 2761
 Horizontal Datum: WGS84, NAD83, NAD27
 Collection Method:

2 WATER WELL OWNER: ADM Grain
 RR#, St. Address, Box #: PO Box 2576
 City, State ZIP Code: Decatur, IL 62525

GPS unit (Make/Model: _____)
 Digital Map/Photo, Topographic Map, Land Survey
 Est. Accuracy: < 3 m, 3-5 m, 5-15 m, > 15 m

3 MARK WELL'S LOCATION WITH AN "X" IN SECTION BOX:

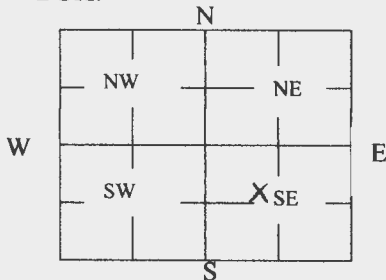

4 DEPTH OF WELL 310 **ft.**

WELL'S STATIC WATER LEVEL 221 ft

WELL WAS USED AS:

- Domestic
- Public Water Supply
- Dewatering
- Irrigation
- Oil Field Water Supply
- Monitoring
- Feedlot
- Domestic (Lawn & Garden)
- Injection Well
- Industrial
- Air Conditioning
- Other _____

Was a chemical/bacteriological sample submitted to Department? Yes No

5 TYPE OF BLANK CASING USED:

- Steel
- RMP (SR)
- Wrought
- Fiberglass
- Other (Specify below) _____
- PVC
- ABS
- Asbestos-Cement
- Concrete Tile

Blank casing diameter 4 in. Was casing pulled? Yes No If yes, how much 5 ft.
 Casing height above or below land surface 0 in.

6 GROUT PLUG MATERIAL: Neat cement Cement grout Bentonite Other _____

Grout Plug Intervals: From 0 ft. to 310 ft., From _____ ft. to _____ ft., From _____ ft. to _____ ft.

What is the nearest source of possible contamination:


- Septic tank
 - Seepage pit
 - Fuel storage
 - Other (specify below) _____
 - Sewer lines
 - Pit privy
 - Fertilizer storage
 - Watertight sewer lines
 - Sewage lagoon
 - Insecticide storage
 - Lateral lines
 - Feedyard
 - Abandoned water well
 - Oil well/Gas well
 - Cess pool
 - Livestock pens
- Direction from well? contaminated site
 How many feet? 0

FROM	TO	PLUGGING MATERIALS	FROM	TO	PLUGGING MATERIALS
0	310	Bentonite			


7 CONTRACTOR'S OR LANDOWNER'S CERTIFICATION: This water well was plugged under my jurisdiction and was completed on (mo/day/year) 2/7/2023 and this record is true to the best of my knowledge and belief. Kansas Water Well Contractor's License No. 604. This Water Well Record was completed on (mo/day/year) 3/6/23 under the business name of Environmental Priority Service, Inc. by (signature) [Signature]

Send one white copy to Kansas Department of Health & Environment, Geology Section, 1000 SW Jackson Street, Ste. 420, Topeka, KS 66612-1367. Send one copy to WATER WELL OWNER and retain one for your records.
 Visit us at <http://www.kdheks.gov/waterwell/index.html> Telephone 785-296-5524.

T. 32 R. 30W Sec. 16
Meade County

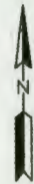

**SITE
AERIAL
MAP**

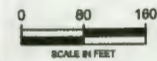

**ADM
PLAINS MAIN FACILITY
MEADE COUNTY
KANSAS**

DATE: APRIL 2021

SCALE: 1" = 160'

DRAWN BY: NRB

APPROVED: HD

FIGURE 2

NOTES:

- PHOTOSOURCE: GOOGLE EARTH IMAGE DATE JUNE 2013. DATE ACCESSED APRIL 2015.
- MONITORING WELL LOCATIONS PROVIDED BY CORNERSTONE REGIONAL SURVEYING LLC FOR HUFF & HUFF, INC. SURVEY FILE DATED 01/28/14.
- PROPERTY LINE DIGITIZED FROM MEADE COUNTY, KANSAS APPRAISAL FIGURES.

LEGEND

- PROPERTY LINE/NFA AREA (APPROXIMATE)
- AREA OF GROUNDWATER USE RESTRICTION
- AREA OF INSPECTION AND NO DISTURBANCE
- SUBSURFACE GEOMEMBRANE CAP
- MONITORING WELL