

WATER WELL PLUGGING RECORD Form WWC-5P

KSA 82a-1212 ID NO.

MW-202


1 LOCATION OF WATER WELL: County: Meade	Fraction NW ¼ NE ¼ SW ¼ SE ¼	Section Number 16	Township Number T 32 S	Range Number 30 <input type="checkbox"/> E <input checked="" type="checkbox"/> W
--	--	-----------------------------	----------------------------------	--

Street/Rural Address of Well Location; if unknown, distance & direction from nearest town or intersection: If at owner's address, check here 304 Grand Avenue, Plains, Ks.

Global Positioning Systems (GPS) information:
 Latitude: 37.2601 (in decimal degrees)
 Longitude: 100.5870 (in decimal degrees)
 Elevation: 2761
 Horizontal Datum: WGS84, NAD83, NAD27
 Collection Method:

2 WATER WELL OWNER: ADM Grain
 RR#, St. Address, Box #: PO Box 2576
 City, State ZIP Code: Decatur, IL 62525

GPS unit (Make/Model): _____
 Digital Map/Photo, Topographic Map, Land Survey
 Est. Accuracy: < 3 m, 3-5 m, 5-15 m, > 15 m

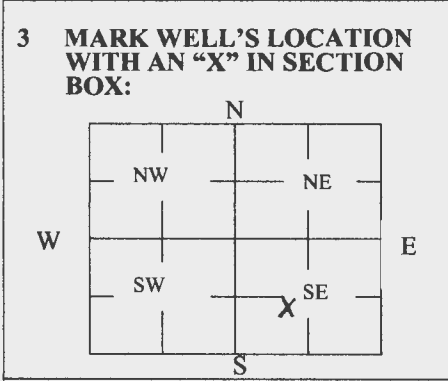

4 DEPTH OF WELL 310 ft.
 WELL'S STATIC WATER LEVEL 249 ft.
 WELL WAS USED AS:

<input type="checkbox"/> Domestic	<input type="checkbox"/> Public Water Supply	<input type="checkbox"/> Dewatering
<input type="checkbox"/> Irrigation	<input type="checkbox"/> Oil Field Water Supply	<input checked="" type="checkbox"/> Monitoring
<input type="checkbox"/> Feedlot	<input type="checkbox"/> Domestic (Lawn & Garden)	<input type="checkbox"/> Injection Well
<input type="checkbox"/> Industrial	<input type="checkbox"/> Air Conditioning	<input type="checkbox"/> Other _____

Was a chemical/bacteriological sample submitted to Department? Yes No

5 TYPE OF BLANK CASING USED:

<input type="checkbox"/> Steel	<input type="checkbox"/> RMP (SR)	<input type="checkbox"/> Wrought	<input type="checkbox"/> Fiberglass	<input type="checkbox"/> Other (Specify below)
<input checked="" type="checkbox"/> PVC	<input type="checkbox"/> ABS	<input type="checkbox"/> Asbestos-Cement	<input type="checkbox"/> Concrete Tile	_____

Blank casing diameter 4 in. Was casing pulled? Yes No If yes, how much 2.5 ft.
 Casing height above or below land surface 0 in.

6 GROUT PLUG MATERIAL: Neat cement Cement grout Bentonite Other _____

Grout Plug Intervals: From 0 ft. to 310 ft., From _____ ft. to _____ ft., From _____ ft. to _____ ft.

What is the nearest source of possible contamination:

<input type="checkbox"/> Septic tank	<input type="checkbox"/> Seepage pit	<input type="checkbox"/> Fuel storage	<input type="checkbox"/> Other (specify below)
<input type="checkbox"/> Sewer lines	<input type="checkbox"/> Pit privy	<input checked="" type="checkbox"/> Fertilizer storage	_____
<input type="checkbox"/> Watertight sewer lines	<input type="checkbox"/> Sewage lagoon	<input type="checkbox"/> Insecticide storage	_____
<input type="checkbox"/> Lateral lines	<input type="checkbox"/> Feedyard	<input type="checkbox"/> Abandoned water well	Direction from well? <u>contaminated site</u>
<input type="checkbox"/> Cess pool	<input type="checkbox"/> Livestock pens	<input type="checkbox"/> Oil well/Gas well	How many feet? <u>0</u>

FROM	TO	PLUGGING MATERIALS	FROM	TO	PLUGGING MATERIALS
0	310	Bentonite			


7 CONTRACTOR'S OR LANDOWNER'S CERTIFICATION: This water well was plugged under my jurisdiction and was completed on (mo/day/year) 2/7/2023 and this record is true to the best of my knowledge and belief. Kansas Water Well Contractor's License No. 604. This Water Well Record was completed on (mo/day/year) 3/6/23 under the business name of Environmental Priority Service, Inc. by (signature) [Signature]

Send one white copy to Kansas Department of Health & Environment, Geology Section, 1000 SW Jackson Street, Ste. 420, Topeka, KS 66612-1367. Send one copy to WATER WELL OWNER and retain one for your records.
 Visit us at <http://www.kdheks.gov/waterwell/index.html> Telephone 785-296-5524.

T. 32 R. 30W Sec. 16
Meade County



**SITE
AERIAL
MAP**

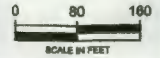

**ADM
PLAINS MAIN FACILITY
MEADE COUNTY
KANSAS**

DATE: APRIL 2021

SCALE: 1"=180'

DRAWN BY: NRB

APPROVED: HD

FIGURE 2

NOTES:

- PHOTOSOURCE: GOOGLE EARTH IMAGE DATE JUNE 2013. DATE ACCESSED APRIL 2015.
- MONITORING WELL LOCATIONS PROVIDED BY CORNERSTONE REGIONAL SURVEYING LLC FOR HUFF & HUFF, INC. SURVEY FILE DATED 01/28/14.
- PROPERTY LINE DIGITIZED FROM MEADE COUNTY, KANSAS APPRAISAL FIGURES.

LEGEND

- PROPERTY LINE/WFA AREA (APPROXIMATE)
- EUC AREA OF INSPECTION AND NO DISTURBANCE
- EUC AREA OF GROUNDWATER USE RESTRICTION
- SUBSURFACE GEOMEMBRANE CAP
- MONITORING WELL