

WATER WELL RECORD

Form WWC-5

Division of Water Resources App. No.


6249

| | | | | |
|--|------------------------------|---------------------|------------------------|---|
| 1 LOCATION OF WATER WELL: County: Seward | Fraction ¼ NE ¼ NW ¼ NW ¼ | Section Number 8 | Township No. T 32 S | Range Number R 31 <input type="checkbox"/> E <input checked="" type="checkbox"/> W |
|--|------------------------------|---------------------|------------------------|---|

Street/Rural Address of Well Location; if unknown, distance & direction from nearest town or intersection: If at owner's address, check here approx 14 miles southeast of Sublette, KS

Global Positioning System (GPS) information:
 Latitude: .37.28582..... (in decimal degrees)
 Longitude: 100.72349..... (in decimal degrees)
 Elevation: 2818.....
 Datum: WGS 84, NAD 83, NAD 27
 Collection Method:
 GPS unit (Make/Model:)
 Digital Map/Photo, Topographic Map, Land Survey
 Est. Accuracy: <3 m, 3-5 m, 5-15 m, >15 m

2 WATER WELL OWNER: Stan Reiss
 RR#, Street Address, Box #: PO Box 8
 City, State, ZIP Code : Plains, KS 67869

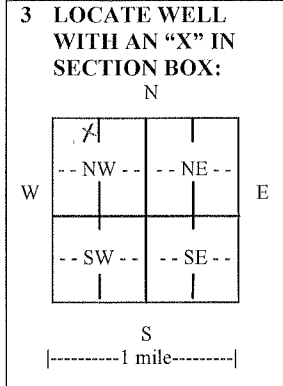

4 DEPTH OF COMPLETED WELL 498..... ft.

Depth(s) Groundwater Encountered (1)..... ft. (2)..... ft. (3)..... ft.

WELL'S STATIC WATER LEVEL.....ft. below land surface measured on mo/day/yr. 6/1/11.....

Pump test data: Well water was .292.....ft. after .4..... hours pumping, .1338..... gpm

EST. YIELD.....gpm. Well water was.....ft. after..... hours pumping..... gpm

Bore Hole Diameter 24.....in. to .498.....ft., andin. toft.

WELL WATER TO BE USED AS: Public water supply Geothermal Injection well
 Domestic Feedlot Oil field water supply Dewatering Other (Specify below)
 Irrigation Industrial Domestic-lawn & garden Monitoring well

Was a chemical/bacteriological sample submitted to Department? Yes No
 If yes, mo/day/yr sample was submitted.....

Water well disinfected? Yes No

5 TYPE OF CASING USED: Steel PVC Other

CASING JOINTS: Glued Clamped Welded Threaded

Casing diameter .16..... in. to .498..... ft., Diameter in. to ft., Diameter in. to ft.

Casing height above land surface .12..... in., Weight 42.09.....lbs./ft., Wall thickness or gauge No. .0.250.....

TYPE OF SCREEN OR PERFORATION MATERIAL:
 Steel Stainless Steel PVC Other (Specify)
 Brass Galvanized Steel None used (open hole)

SCREEN OR PERFORATION OPENINGS ARE:
 Continuous slot Mill slot Gauze wrapped Torch cut Drilled holes None (open hole)
 Louvered shutter Key punched Wire wrapped Saw cut Other (specify)

SCREEN-PERFORATED INTERVALS: From .283..... ft. to .423..... ft., From .423..... ft. to .493..... ft.
 From..... ft. to ft., From..... ft. to ft.

GRAVEL PACK INTERVALS: From .20..... ft. to .430..... ft., From .430..... ft. to .498..... ft.
 From..... ft. to ft., From..... ft. to ft.

6 GROUT MATERIAL: Neat cement Cement grout Bentonite Other

Grout Intervals: From .0..... ft. to .20..... ft., From..... ft. to ft., From..... ft. to ft.

What is the nearest source of possible contamination:
 Septic tank Lateral lines Pit privy Livestock pens Insecticide storage Other (specify below)
 Sewer lines Cesspool Sewage lagoon Fuel storage Abandoned water well
 Watertight sewer lines Seepage pit Feedyard Fertilizer storage Oil well/gas well None Detected

Direction from well Distance from well

| FROM | TO | LITHOLOGIC LOG | FROM | TO | LITHO. LOG (cont.) or PLUGGING INTERVALS |
|------|-----|------------------------------------|------|-----|--|
| 0 | 1 | surface | 170 | 175 | brown clay |
| 1 | 11 | brown silty clay, fine sand | 175 | 253 | snd fn-sm few md thin clys few crse |
| 11 | 24 | brown clay, cemented sand | 253 | 260 | brown clay |
| 24 | 40 | fine sand | 260 | 287 | sand fine to small few clay |
| 40 | 60 | sand fine to med, clays | 287 | 310 | sand fine to small, few med |
| 60 | 76 | sand fne-med crse sm-few lrg grvl | 310 | 319 | brown clay few sand |
| 76 | 81 | brown clay | 319 | 348 | sand fine to small few clay |
| 81 | 130 | sand fne-med crse sm-few med grvl | 348 | 362 | sand fine to med coarse. few clay |
| 130 | 144 | brown-white clay, blue + gray clay | 362 | 387 | sand fine to small, thin clays |
| 144 | 170 | sand fine to small, few thin clays | 387 | 397 | snd fne-small, some mud, thin clays |

7 CONTRACTOR'S OR LANDOWNER'S CERTIFICATION: This water well was constructed, reconstructed, or plugged under my jurisdiction and was completed on (mo/day/year) .6/1/11..... and this record is true to the best of my knowledge and belief. Kansas Water Well Contractor's License No. .145..... This Water Well Record was completed on (mo/day/year) .6/25/11..... under the business name of ..Hydro Resources..... by (signature)

INSTRUCTIONS: Use typewriter or ball point pen. PLEASE PRESS FIRMLY and PRINT clearly. Please fill in blanks and check the correct answers. Send three copies (white, blue, pink) to Kansas Department of Health and Environment, Bureau of Water, Geology Section, 1000 SW Jackson St., Suite 420, Topeka, Kansas 66612-1367. Telephone 785-296-5522. Send one copy to WATER WELL OWNER and retain one for your records. Include fee of \$5.00 for each constructed well. Visit us at <http://www.kdheks.gov/waterwell/index.html>.

WATER WELL RECORD

Form WWC-5

Division of Water Resources App. No.


6249

| | | | | |
|--|------------------------------|---------------------|------------------------|---|
| 1 LOCATION OF WATER WELL: County: Seward | Fraction ¼ NE ¼ NW ¼ NW ¼ | Section Number 8 | Township No. T 32 S | Range Number R 31 <input type="checkbox"/> E <input checked="" type="checkbox"/> W |
|--|------------------------------|---------------------|------------------------|---|

Street/Rural Address of Well Location; if unknown, distance & direction from nearest town or intersection: If at owner's address, check here .

Global Positioning System (GPS) information:
 Latitude: (in decimal degrees)
 Longitude: (in decimal degrees)
 Elevation:
 Datum: WGS 84, NAD 83, NAD 27
 Collection Method:
 GPS unit (Make/Model:)
 Digital Map/Photo, Topographic Map, Land Survey
 Est. Accuracy: <3 m, 3-5 m, 5-15 m, >15 m

2 WATER WELL OWNER: Stan Reiss
 RR#, Street Address, Box #: PO Box 8
 City, State, ZIP Code : Plains, KS 67869

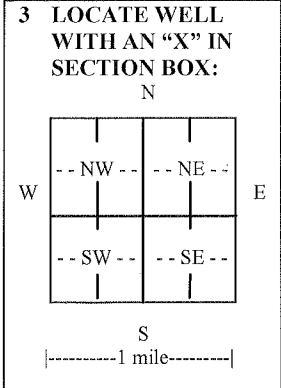

4 DEPTH OF COMPLETED WELL ft.

Depth(s) Groundwater Encountered (1)..... ft. (2)..... ft. (3)..... ft.

WELL'S STATIC WATER LEVEL.....ft. below land surface measured on mo/day/yr.....

Pump test data: Well water was.....ft. after..... hours pumping..... gpm

EST. YIELD.....gpm. Well water was.....ft. after..... hours pumping..... gpm

Bore Hole Diameterin. toft., andin. toft.

WELL WATER TO BE USED AS: Public water supply Geothermal Injection well
 Domestic Feedlot Oil field water supply Dewatering Other (Specify below)
 Irrigation Industrial Domestic-lawn & garden Monitoring well

Was a chemical/bacteriological sample submitted to Department? Yes No

If yes, mo/day/yr sample was submitted.....

Water well disinfected? Yes No

5 TYPE OF CASING USED: Steel PVC Other

CASING JOINTS: Glued Clamped Welded Threaded

Casing diameter in. to ft., Diameter in. to ft., Diameter in. to ft.

Casing height above land surface..... in., Weightlbs./ft., Wall thickness or gauge No.

TYPE OF SCREEN OR PERFORATION MATERIAL:
 Steel Stainless Steel PVC Other (Specify)
 Brass Galvanized Steel None used (open hole)

SCREEN OR PERFORATION OPENINGS ARE:
 Continuous slot Mill slot Gauze wrapped Torch cut Drilled holes None (open hole)
 Louvered shutter Key punched Wire wrapped Saw cut Other (specify)

SCREEN-PERFORATED INTERVALS: From..... ft. to ft., From ft. to ft.
 From..... ft. to ft., From ft. to ft.

GRAVEL PACK INTERVALS: From..... ft. to ft., From ft. to ft.
 From..... ft. to ft., From ft. to ft.

6 GROUT MATERIAL: Neat cement Cement grout Bentonite Other

Grout Intervals: From ft. to ft., From ft. to ft., From ft. to ft.

What is the nearest source of possible contamination:
 Septic tank Lateral lines Pit privy Livestock pens Insecticide storage Other (specify below)
 Sewer lines Cesspool Sewage lagoon Fuel storage Abandoned water well
 Watertight sewer lines Seepage pit Feedyard Fertilizer storage Oil well/gas well

Direction from well Distance from well

| FROM | TO | LITHOLOGIC LOG | FROM | TO | LITHO. LOG (cont.) or PLUGGING INTERVALS |
|------|-----|--------------------------------------|------|----|--|
| 397 | 421 | snd fine-small, thin clys few ledges | | | |
| 421 | 442 | brwn-white cly, lmerck, cmtd snd | | | |
| 442 | 451 | sand fine, clays mixed | | | |
| 451 | 458 | brown clay, limerock some soapstone | | | |
| 458 | 493 | brwn+ylw sandstone, sluffing clys | | | |
| 493 | 498 | soapstone, limestone | | | |
| | | | | | |
| | | | | | |
| | | | | | |

7 CONTRACTOR'S OR LANDOWNER'S CERTIFICATION: This water well was constructed, reconstructed, or plugged under my jurisdiction and was completed on (mo/day/year) and this record is true to the best of my knowledge and belief. Kansas Water Well Contractor's License No. This Water Well Record was completed on (mo/day/year) under the business name of by (signature)

INSTRUCTIONS: Use typewriter or ball point pen. PLEASE PRESS FIRMLY and PRINT clearly. Please fill in blanks and check the correct answers. Send three copies (white, blue, pink) to Kansas Department of Health and Environment, Bureau of Water, Geology Section, 1000 SW Jackson St., Suite 420, Topeka, Kansas 66612-1367. Telephone 785-296-5522. Send one copy to WATER WELL OWNER and retain one for your records. Include fee of \$5.00 for each constructed well. Visit us at <http://www.kdheks.gov/waterwell/index.html>.