USE TYPEWRITER OR BALL POINT PEN-PRESS FIRMLY, PRINT CLEARLY.

WATER WELL RECORD
KSA 82a-1201-1215

Kansas Department of Health and Environment-Division of Environment
(Water well Contractors)
Topeka, Kansas 66620

1. Location of well:	County	Fraction	Section number	Township number	Range number
	Seward	NW1/4 NW1/4 SE1/4	11	T 32 S	R 31 E/W

2. Distance and direction from nearest town or city: 5 1/2 West + 1/2
Street address of well location if in city: North Plains Kan

3. Owner of well: Ted Dritz
R.R. or street:
City, state, zip code: Plains Kan 67869

4. Locate with "X" in section below:

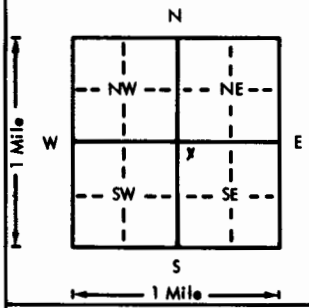

Sketch map:

6. Bore hole dia. 26 in. Completion date
Well depth 408 ft.

7. __ Cable tool ✓ Rotary __ Driven __ Dug
__ Hollow rod __ Jetted __ Bored __ Reverse rotary

8. Use: __ Domestic __ Public supply __ Industry
✓ Irrigation __ Air conditioning __ Stock
__ Lawn __ Oil field water __ Other

9. Casing: Material Steel Height: Above or below
Threaded ___ Welded ✓ Surface 12 in.
RMP ___ PVC ___ Weight ___ lbs./ft.
Dia. 16 in. to 408 ft. depth Wall Thickness: inches or
Dia. ___ in. to ___ ft. depth gage No. .219

5. Type and color of material	From	To
Coarse Sand Clay Stks	140	160
Med " " " "	160	180
" " " Gravel	180	200
" " " " Clay	200	220
" " " " "	220	240
" " " " "	240	260
" " " " "	260	280
" " " " "	280	300
Coarse Blue Sand Gravel	300	320
" " " " Clay	320	340
" " " " "	340	360
" " " " "	360	380
Coarse Sand Gravel Clay	380	400
Brown Clay + Med Sand	400	420

(Use a second sheet if needed)

10. Screen: Manufacturer's name Brown Jam Flo
Type 10% Dia. 16
Slot/gauze 18 Length 200
Set between 208 ft. and 408 ft.
___ ft. and ___ ft.
Gravel pack? ✓ Size range of material 3/8 down

11. Static water level: mo./day/yr.
171 ft. below land surface Date Sept 10

12. Pumping level below land surfaces:
350 ft. after 2 hrs. pumping 1150 g.p.m.
___ ft. after ___ hrs. pumping ___ g.p.m.
Estimated maximum yield ___ g.p.m.

13. Water sample submitted: mo./day/yr.
__ Yes ✓ No Date

14. Well head completion:
__ Pitless adapter 12 inches above grade

15. Well grouted? yes
With: __ Neat cement ✓ Bentonite __ Concrete
Depth: From 0 ft. to 10 ft.

16. Nearest source of possible contamination: None
ft. ___ Direction ___ Type ___
Well disinfected upon completion? ___ Yes ___ No

17. Pump: ✓ Not installed
Manufacturer's name Peerless
Model number ___ HP ___ Volts ___
Length of drop pipe 360 ft. capacity ___ g.p.m.
Type:
__ Submersible ✓ Turbine
__ Jet __ Reciprocating
__ Centrifugal __ Other

18. Elevation:
Topography:
✓ Hill
__ Slope
__ Upland
__ Valley

19. Remarks:

20. Water well contractor's certification:
This well was drilled under my jurisdiction and this report is true to the best of my knowledge and belief.
Allen + Rawlins 322A
Business name License No.
Address Box 130 Meade Kan
Signed Albert Rawlins Date 9-22-76
Authorized representative

T 32 S R 31 E (W) Sec 11 1/4 NW 1/4 NW 1/4 SE 1/4

Forward the white, blue and pink copies to the Department of Health and Environment

Form WWC-5

MI-1023