


1 LOCATION OF WATER WELL: Fraction ~~NW~~ NE ~~NE~~ NE Section Number 31 Township Number T 32 S Range Number R 32 E 01
 County: Seward

Distance and direction from nearest town or city street address of well if located within city?
13 miles N, 1 1/2 miles E, + 1/4 mile S of Liberal

2 WATER WELL OWNER: Steve Eisenhower
 RR#, St. Address, Box #: RR1 Box 202 Board of Agriculture, Division of Water Resources
 City, State, ZIP Code: Liberal, KS 67901 Application Number:

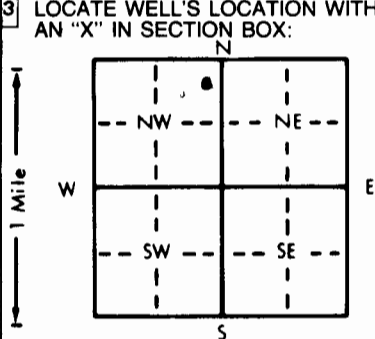

4 DEPTH OF COMPLETED WELL: 270 ft. ELEVATION:
 Depth(s) Groundwater Encountered 1. ft. 2. ft. 3. ft.
 WELL'S STATIC WATER LEVEL: 9.9 ft. below land surface measured on mo/day/yr 10-31-96
 Pump test data: Well water was 105 ft. after 1 1/2 hours pumping 30 gpm
 Est. Yield 50 gpm. Well water was ft. after hours pumping gpm
 Bore Hole Diameter: 8.34 in. to 2.70 ft., and in. to ft.
 WELL WATER TO BE USED AS:
 Domestic 3 Feedlot 6 Oil field water supply 9 Dewatering 12 Other (Specify below)
 2 Irrigation 4 Industrial 7 Lawn and garden only 10 Monitoring well
 Was a chemical/bacteriological sample submitted to Department? Yes.....No ; If yes, mo/day/yr sample was submitted
 Water Well Disinfected? Yes No

5 TYPE OF BLANK CASING USED:
 1 Steel 3 RMP (SR) 5 Wrought iron 8 Concrete tile CASING JOINTS: Glued Clamped
 PVC 4 ABS 6 Asbestos-Cement 9 Other (specify below) Welded
 7 Fiberglass Threaded
 Blank casing diameter 5 in. to 2.10 ft. Dia. in. to ft. Dia. in. to ft.
 Casing height above land surface 2.4 in., weight lbs./ft. Wall thickness or gauge No. 270-250 SDR17
 TYPE OF SCREEN OR PERFORATION MATERIAL:
 PVC 10 Asbestos-cement 250-230 SDR17
 1 Steel 3 Stainless steel 5 Fiberglass 8 RMP (SR) 11 Other (specify) 230-top SDR21
 2 Brass 4 Galvanized steel 6 Concrete tile 9 ABS 12 None used (open hole)
 SCREEN OR PERFORATION OPENINGS ARE:
 Saw cut 11 None (open hole)
 1 Continuous slot 3 Mill slot 6 Wire wrapped 9 Drilled holes
 2 Louvered shutter 4 Key punched 7 Torch cut 10 Other (specify)
 SCREEN-PERFORATED INTERVALS: From 2.10 ft. to 2.70 ft. From ft. to ft.
 From ft. to ft. From ft. to ft.
 GRAVEL PACK INTERVALS: From 2.0 ft. to 2.7 ft. From ft. to ft.
 From ft. to ft. From ft. to ft.

6 GROUT MATERIAL: 1 Neat cement 2 Cement grout Bentonite 4 Other
 Grout Intervals: From 5 ft. to 2.0 ft. From ft. to ft. From ft. to ft.
 What is the nearest source of possible contamination:
 1 Septic tank 4 Lateral lines 7 Pit privy 10 Livestock pens 14 Abandoned water well
 2 Sewer lines 5 Cess pool 8 Sewage lagoon 11 Fuel storage Oil well/Gas well
 3 Watertight sewer lines 6 Seepage pit 9 Feedyard 12 Fertilizer storage 16 Other (specify below)
 13 Insecticide storage
 Direction from well? South How many feet? 1500

FROM	TO	LITHOLOGIC LOG	FROM	TO	PLUGGING INTERVALS
<u>0</u>	<u>170</u>	<u>5% clay + sand + gravel</u>			
<u>170</u>	<u>270</u>	<u>1% clay + sand + gravel</u>			

7 CONTRACTOR'S OR LANDOWNER'S CERTIFICATION: This water well was constructed, (2) reconstructed, or (3) plugged under my jurisdiction and was completed on (mo/day/year) 10-31-96 and this record is true to the best of my knowledge and belief. Kansas Water Well Contractor's License No. 101 This Water Well Record was completed on (mo/day/yr) 10-31-96 under the business name of Bartel Well Drilling, Inc. by (signature) Reuben J. Bartel

INSTRUCTIONS: Use typewriter or ball point pen. PLEASE PRESS FIRMLY and PRINT clearly. Please fill in blanks, underline or circle the correct answers. Send top three copies to Kansas Department of Health and Environment, Bureau of Water, Topeka, Kansas 66620-0001. Telephone: 913-296-5545. Send one to WATER WELL OWNER and retain one for your records.

OFFICE USE ONLY
FW
SEC.