


1 LOCATION OF WATER WELL: Fraction NE 1/4 SE 1/4 NW 1/4 Section Number 14 Township Number T 32 S Range Number R 32 E/W  
 County: SEWARD

Distance and direction from nearest town or city street address of well if located within city?  
Kismet - 4 mi North to Hwy 160 - 4 1/2 mi west + South →

2 WATER WELL OWNER: Bob Walker  
 RR#, St. Address, Box #: Rt 1 Box 98 Board of Agriculture, Division of Water Resources  
 City, State, ZIP Code: Kismet, Mo. 67839 Application Number:

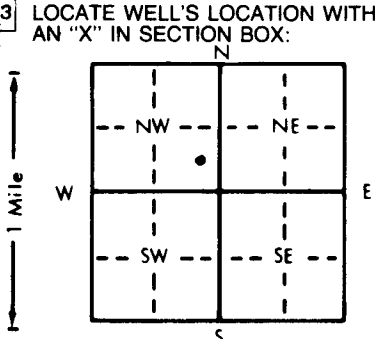

4 DEPTH OF COMPLETED WELL: ..... ft. ELEVATION: ..... ft.  
 Depth(s) Groundwater Encountered 1. .... ft. 2. .... ft. 3. .... ft.  
 WELL'S STATIC WATER LEVEL ..... ft. below land surface measured on mo/day/yr .....  
 Pump test data: Well water was ..... ft. after ..... hours pumping ..... gpm  
 Est. Yield ..... gpm: Well water was ..... ft. after ..... hours pumping ..... gpm  
 Bore Hole Diameter ..... in. to ..... ft., and ..... in. to ..... ft.  
 WELL WATER TO BE USED AS: 5 Public water supply 8 Air conditioning 11 Injection well  
 1 Domestic 3 Feedlot 6 Oil field water supply 9 Dewatering 12 Other (Specify below)  
 2 Irrigation 4 Industrial 7 Lawn and garden only 10 Monitoring well TEST hole  
 Was a chemical/bacteriological sample submitted to Department? Yes.....No.....; If yes, mo/day/yr sample was submitted  
 Water Well Disinfected? Yes No

5 TYPE OF BLANK CASING USED: 5 Wrought iron 8 Concrete tile CASING JOINTS: Glued ..... Clamped .....  
 1 Steel 3 RMP (SR) 6 Asbestos-Cement 9 Other (specify below) Welded .....  
 2 PVC 4 ABS 7 Fiberglass ..... Threaded .....  
 Blank casing diameter ..... in. to ..... ft., Dia ..... in. to ..... ft., Dia ..... in. to ..... ft.  
 Casing height above land surface ..... in., weight ..... lbs./ft. Wall thickness or gauge No. ....  
 TYPE OF SCREEN OR PERFORATION MATERIAL: 7 PVC 10 Asbestos-cement  
 1 Steel 3 Stainless steel 5 Fiberglass 8 RMP (SR) 11 Other (specify) .....  
 2 Brass 4 Galvanized steel 6 Concrete tile 9 ABS 12 None used (open hole)  
 SCREEN OR PERFORATION OPENINGS ARE: 5 Gauzed wrapped 8 Saw cut 11 None (open hole)  
 1 Continuous slot 3 Mill slot 6 Wire wrapped 9 Drilled holes  
 2 Louvered shutter 4 Key punched 7 Torch cut 10 Other (specify) .....  
 SCREEN-PERFORATED INTERVALS: From ..... ft. to ..... ft., From ..... ft. to ..... ft.  
 From ..... ft. to ..... ft., From ..... ft. to ..... ft.  
 GRAVEL PACK INTERVALS: From ..... ft. to ..... ft., From ..... ft. to ..... ft.  
 From ..... ft. to ..... ft., From ..... ft. to ..... ft.

6 GROUT MATERIAL: 1 Neat cement 2 Cement grout 3 Bentonite 4 Other .....  
 Grout Intervals: From ..... ft. to ..... ft., From ..... ft. to ..... ft., From ..... ft. to ..... ft.  
 What is the nearest source of possible contamination: 10 Livestock pens 14 Abandoned water well  
 1 Septic tank 4 Lateral lines 7 Pit privy 11 Fuel storage 15 Oil well/Gas well  
 2 Sewer lines 5 Cess pool 8 Sewage lagoon 12 Fertilizer storage 16 Other (specify below)  
 3 Watertight sewer lines 6 Seepage pit 9 Feedyard 13 Insecticide storage

Direction from well? How many feet?

FROM	TO	LITHOLOGIC LOG	FROM	TO	PLUGGING INTERVALS
0	2	Top	231	243	Black, Yellow Clay & Sand
2	9	Brown Sandy Clay	243	294	course sand w/ tan sandy clay streaks
9	17	Tan Clay	294	337	Tan Sandy Clay w/ fine sand streaks
17	49	Brown Clay & Caliche	337	354	course sand w/ clay streaks
49	73	Brown, tan, white clay	354	360	Blue, white, yellow clay
73	88	Brown + yellow clay	360	374	course sand w/ yellow clay streaks
88	94	sand + small gravel	374	378	white, yellow clay
94	110	Brown, white, yellow clay w/ sandstone	378	389	course sand
110	118	sand w/ tan sandy clay streaks	389	404	Blue, yellow, brown clay
118	131	course sand	404	410	yellow sandy clay
131	142	Brown, yellow, blue clay	410	421	course sand w/ clay streaks
142	164	sand & sm. gravel w/ tan clay	421	438	tan clay & sandstone
164	182	sandstone + brown clay	438	484	yellow sandstone w/ fine sand
182	188	sand	484	493	Tan Sandy Clay
188	231	Brown, yellow, blue clay w/ sand streaks	493	500	Red bed

7 CONTRACTOR'S OR LANDOWNER'S CERTIFICATION: This water well was (1) constructed, (2) reconstructed, or (3) plugged under my jurisdiction and was completed on (mo/day/year) 3-18-97 and this record is true to the best of my knowledge and belief. Kansas Water Well Contractor's License No. 600-A This Water Well Record was completed on (mo/day/yr) 4-4-97 under the business name of CRAMER DRG. Co. by (signature) Ray Cramer