


1 LOCATION OF WATER WELL: Fraction Section Number Township Number Range Number
 County: Seward W 1/4 SW 1/4 NE 1/4 15 32 32 EW

Distance and direction from nearest town or city street address of well if located within city?
4 Miles West & 3 Miles North of Kirmet

2 WATER WELL OWNER: Norman Roehr
 RR #, St. Address, Box #: 16818 Hwy 160
 City, State, ZIP Code: Kirmet, KS 67859
 Board of Agriculture, Division of Water Resources
 Application Number: _____

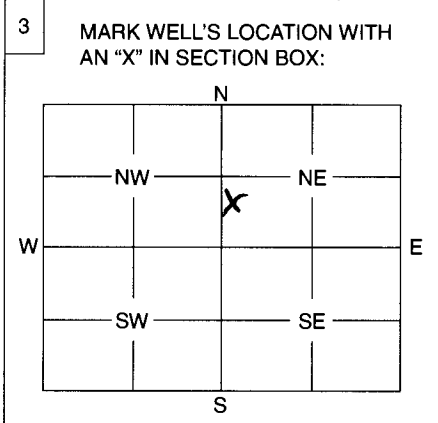

4 DEPTH OF WELL 330 ft.
 WELL'S STATIC WATER LEVEL 297 ft.
 WELL WAS USED AS:
 1 Domestic
 2 Irrigation
 3 Feedlot
 4 Industrial
 5 Public Water Supply
 6 Oil Field Water Supply
 7 Domestic (Lawn & Garden)
 8 Air Conditioning
 9 Dewatering
 10 Monitoring Well
 11 Injection Well
 12 Other
 Was a chemical / bacteriological sample submitted to Department? Yes No
 If yes, mo/day/yr sample was submitted
 Water Well Disinfected: Yes No

5 TYPE OF BLANK CASING USED:
 1 Steel
 2 PVC
 3 RMP (SR)
 4 ABS
 5 Wrought
 6 Asbestos-Cement
 7 Fiberglass
 8 Concrete Tile
 9 Other (Specify below)
 Blank casing diameter 16 in. Was casing pulled? Yes No
 Casing height above or below land surface 60 in. If yes, how much

6 GROUT PLUG MATERIAL: 1 Neat cement 2 Cement grout 3 Bentonite 4 Other
 Grout Plug Intervals: From 10 ft. to 5 ft., From ft. to ft., From to ft.
 What is the nearest source of possible contamination:
 1 Sepsic tank
 2 Sewer lines
 3 Watertight sewer lines
 4 Lateral lines
 5 Cess pool
 6 Seepage pit
 7 Pit privy
 8 Sewage lagoon
 9 Feedyard
 10 Livestock pens
 11 Fuel storage
 12 Fertilizer storage
 13 Insecticide storage
 14 Abandoned water well
 15 Oil well/Gas well
 16 Other (specify below)
 Direction from well? North east How many feet? 2500

FROM	TO	PLUGGING MATERIALS
330	250	Chlorinated Sand
250	10	Clay / Subsoil
10	5	Bentonite
5	-	Cut-off casing & backfill

7 CONTRACTOR'S OF LANDOWNER'S CERTIFICATION: This water well was plugged under my jurisdiction and was completed on (mo/day/year) 8-6-14 and this record is true to the best of my knowledge and belief. Kansas Water Well Contractor's License No. 805 This Water Well Record was completed on (mo/day/year) 8-7-14 under the business name of Southwest Windmill by (signature) David Enns

INSTRUCTIONS: Use typewriter or ball point pen. Please press firmly and print clearly. Please fill in blanks, underline or circle the correct answers. Send top three copies to Kansas Department of Health and Environment, Bureau of Water, Geology Section, 1000 SW Jackson St., Ste. 420, Topeka, Kansas 66612-1367. Telephone: 785/296-5522. Send one to Water Well Owner and retain one for your records.