


1 LOCATION OF WATER WELL:	Fraction	Section Number	Township Number	Range Number
County: Seward	NE 1/4 NE 1/4 NW 1/4	10	T 32 S	R 32 E/W

Distance and direction from nearest town or city street address of well if located within city? From Kismet - $\frac{1}{2}$ Mile North, $1\frac{1}{2}$ Miles West, 4 Miles North, 3 Miles West, 5180 Ft. North & 2985 Ft. West.

2] WATER WELL OWNER:	John Hancock Mutual Life Ins. Co.	
RR#, St. Address, Box # :	2201 Civic Circle, Suite 630	Board of Agriculture, Division of Water Resources
City, State, ZIP Code :	Amarillo, Texas 79109	Application Number: 9,992 & 26,206

3 LOCATE WELL'S LOCATION WITH AN "X" IN SECTION BOX: 4 DEPTH OF COMPLETED WELL... 470... ft. ELEVATION: ...
Depth(s) Groundwater Encountered 1. ... ft. 2. ... ft. 3. ... ft.

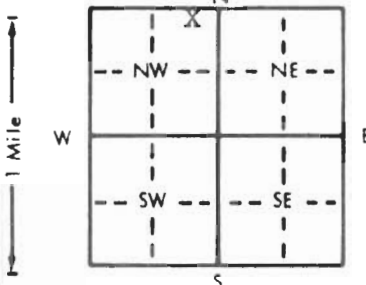

4 DEPTH OF COMPLETED WELL . . . 470 . . . ft. ELEVATION:

Depth(s) Groundwater Encountered 1. ft. 2. ft. 3. ft.

WELL'S STATIC WATER LEVEL . . . 238 . . . ft. below land surface measured on mo/day/yr 4=12-91

Pump test data: Well water was ft. after hours pumping gpm

Est. Yield gpm: Well water was ft. after hours pumping gpm

Bore Hole Diameter . . . 30 . . . in. to . . . 470 . . . ft., and in. to ft.

WELL WATER TO BE USED AS:

5 Public water supply	8 Air conditioning	11 Injection well		
1 Domestic	3 Feedlot	6 Oil field water supply	9 Dewatering	12 Other (Specify below)
2 Irrigation	4 Industrial	7 Lawn and garden only	10 Monitoring well	

Was a chemical/bacteriological sample submitted to Department? Yes No. ☒; If yes, mo/day/yr sample was submitted

Water Well Disinfected? Yes No ☒

5	TYPE OF BLANK CASING USED:	5 Wrought iron	8 Concrete tile	CASING JOINTS: Glued Clamped
	① Steel 3 RMP (SR)	6 Asbestos-Cement	9 Other (specify below)	Welded XX

Blank casing diameter . . . 16 in. to 385 ft., Dia . . . 20 in. to 345 ft., Dia . . . 20 in. to 400 ft.
Casing height above land surface . . . 12 in., weight 16"- 42.05 lbs./ft. Wall thickness or gauge No. 250
TYPE OF SCREEN OR PERFORATION MATERIAL . . . 20"- 52-73

TYPE OF SCREEN OR PERFORATION MATERIAL:

1 Steel	3 Stainless steel	5 Fiberglass	8 RMP (SR)	10 Asbestos-cement
2 Brass	4 Galvanized steel	6 Concrete tile	9 ABS	11 Other (specify)
				12 None used (open hole)

SCREEN OR PERFORATION OPENINGS ARE:

1 Continuous slot	3 Mill slot	5 Gauzed wrapped	8 Saw cut	11 None (open hole)
2 Louvered shutter	4 Key punched	6 Wire wrapped	9 Drilled holes	
		7 Torch cut	10 Other (specify)	

SCREEN-PERFORATED INTERVALS:	204	From	255	ft. to	305	ft. From	345	ft. to	385	ft.
	16"	From	400	ft. to	470	ft. From		ft. to		ft.
GRAVEL PACK INTERVALS:		From	20	ft. to	190	ft. From	250	ft. to	470	ft.
		From		ft. to		ft. From		ft. to		ft.

6 GROUT MATERIAL: 1 Neat cement 2 Cement grout 3 Bentonite 4 Other
Grout Intervals: From 0 ft. to 20 ft. From 190 ft. to 250 ft. From ft. to ft.
What is the nearest source of possible contamination: 10 Livestock pens 14 Abandoned water well

What is the nearest source of possible contamination?

1 Septic tank	4 Lateral lines	7 Pit privy	10 Livestock pens	13 Abandoned water well
2 Sewer lines	5 Cess pool	8 Sewage lagoon	11 Fuel storage	15 Oil well/Gas well
3 Watertight sewer lines	6 Seepage pit	9 Feedyard	12 Fertilizer storage	16 Other (specify below)

Direction from well? **East**

How many feet? **285**

FROM	TO	LITHOLOGIC LOG	FROM	TO	PLUGGING INTERVALS
		See attached log			

7 CONTRACTOR'S OR LANDOWNER'S CERTIFICATION: This water well was (1) constructed, (2) reconstructed, or (3) plugged under my jurisdiction and was completed on (mo/day/year) 5-3-91 and this record is true to the best of my knowledge and belief. Kansas Water Well Contractor's License No. 208 This Water Well Record was completed on (mo/day/yr) 5-29-91 under the business name of Minter-Wilson Drilling Co., Inc. by (signature) Nora Keelor