


1 LOCATION OF WATER WELL: Fraction NE 1/4 NE 1/4 NE 1/4 Section Number 20 Township Number T 32 S Range Number R 32 E/W  
 County: Seward

Distance and direction from nearest town or city street address of well if located within city?  
 3 1/2 North and 6 1/2 West of Kismet, Kansas

2 WATER WELL OWNER: Duane Lambert  
 RR#, St. Address, Box #: Rt. 1, Box 88 Board of Agriculture, Division of Water Resources  
 City, State, ZIP Code: Kismet, KS 67859 Application Number: ---

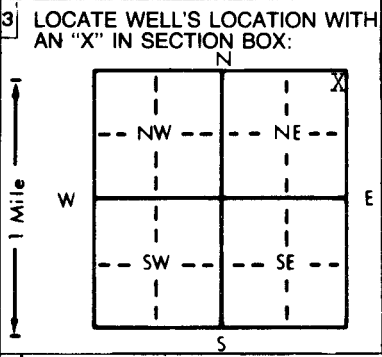

4 DEPTH OF COMPLETED WELL: 420 ft. ELEVATION: Slope  
 Depth(s) Groundwater Encountered 1. Not available ft. 2. ft. 3. ft.  
 WELL'S STATIC WATER LEVEL: 250 ft. below land surface measured on mo/day/yr July 19, 1990  
 Pump test data: Well water was ft. after hours pumping gpm  
 Est. Yield 30 gpm: Well water was ft. after hours pumping gpm  
 Bore Hole Diameter: 10 in. to 420 ft., and in. to ft.  
 WELL WATER TO BE USED AS:  
 5 Public water supply  8 Air conditioning  11 Injection well  
 2 Domestic  3 Feedlot  6 Oil field water supply  9 Dewatering  12 Other (Specify below)  
 2 Irrigation  4 Industrial  7 Lawn and garden only  10 Monitoring well  
 Was a chemical/bacteriological sample submitted to Department? Yes No ; If yes, mo/day/yr sample was submitted  
 Water Well Disinfected? Yes  No

5 TYPE OF BLANK CASING USED:  
 1 Steel 3 RMP (SR) 5 Wrought iron 8 Concrete tile CASING JOINTS: Glued  Clamped  
 PVC 4 ABS 6 Asbestos-Cement 9 Other (specify below) Welded  
 7 Fiberglass Threaded  
 Blank casing diameter 5 in. to 380 ft., Dia in. to ft., Dia in. to ft.  
 Casing height above land surface 18 in., weight 2.8 lbs./ft. Wall thickness or gauge No. 265  
 TYPE OF SCREEN OR PERFORATION MATERIAL:  
 PVC 10 Asbestos-cement  
 1 Steel 3 Stainless steel 5 Fiberglass 8 RMP (SR) 11 Other (specify)  
 2 Brass 4 Galvanized steel 6 Concrete tile 9 ABS 12 None used (open hole)  
 SCREEN OR PERFORATION OPENINGS ARE:  
 5 Gauzed wrapped  Saw cut 11 None (open hole)  
 1 Continuous slot 3 Mill slot 6 Wire wrapped 9 Drilled holes  
 2 Louvered shutter 4 Key punched 7 Torch cut 10 Other (specify)  
 SCREEN-PERFORATED INTERVALS: From 380 ft. to 420 ft., From ft. to ft.  
 GRAVEL PACK INTERVALS: From 30 ft. to 420 ft., From ft. to ft.

6 GROUT MATERIAL: 1 Neat cement 2 Cement grout 3 Bentonite  Other Baroid Hole Plug  
 Grout Intervals: From 0 ft. to 30 ft., From ft. to ft., From ft. to ft.  
 What is the nearest source of possible contamination:  
 Septic tank 4 Lateral lines 7 Pit privy 10 Livestock pens 14 Abandoned water well  
 2 Sewer lines 5 Cess pool 8 Sewage lagoon 11 Fuel storage 15 Oil well/Gas well  
 3 Watertight sewer lines 6 Seepage pit 9 Feedyard 12 Fertilizer storage 16 Other (specify below)  
 13 Insecticide storage  
 Direction from well? West How many feet? 100

FROM	TO	LITHOLOGIC LOG	FROM	TO	PLUGGING INTERVALS
0	2	Topsoil			
2	121	Clay			
121	180	Med. to Lar. Sand			
180	240	Clay			
240	420	Med. to Lar. Sand & Gravel			

7 CONTRACTOR'S OR LANDOWNER'S CERTIFICATION: This water well was (1) constructed, (2) reconstructed, or (3) plugged under my jurisdiction and was completed on (mo/day/year) July 27, 1990 and this record is true to the best of my knowledge and belief. Kansas Water Well Contractor's License No. 252 This Water Well Record was completed on (mo/day/yr) August 13, 1990 under the business name of Friesen Windmill & Supply Inn. by (signature)

INSTRUCTIONS: Use typewriter or ball point pen. PLEASE PRESS FIRMLY and PRINT clearly. Please fill in blanks, underline or circle the correct answers. Send top three copies to Kansas Department of Health and Environment, Bureau of Water, Topeka, Kansas 66620-7320. Telephone: 913-296-5545. Send one to WATER WELL OWNER and retain one for your records.