USE TYPEWRITER OR BALL POINT PEN-PRESS FIRMLY, PRINT CLEARLY.

T R EW sec 1/4 1/4 1/4 No.

WATER WELL RECORD
KSA 82a-1201-1215

Kansas State Dept. Of Health
(Water Well Contractors)
Forbes-Bldg. 740
Topeka, Kansas 66620

Fedders A-1 CWW Inv. 11362

1 Location of well:	County	Township name	Fraction	Section number	Town number	Range number
	Seward		C SW NW	23	32S	32W

Distance and direction from nearest town or city: 15 miles north of liberal, 5 east, 1½ south

Street address of well location if in city:

3 Owner of well: Cities Service Oil Co.
Address: 3545 NW 58th Street
Oklahoma City, Oklahoma 73112

Locate with "X" in section below:

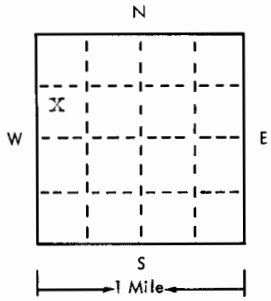

Sketch map:

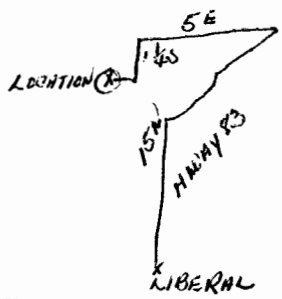

4 Well depth: 300 ft. Date of completion 5-31-75
Well diameter 10 in.

5 ☐ Cable tool ☒ Rotary ☐ Driven ☐ Dug
☐ Hollow rod ☐ Jetted ☐ Bored ☐ Reverse rotary

6 Use: ☐ Domestic ☐ Public supply ☒ Industry
☐ Irrigation ☐ Air conditioning ☐ Commercial
☐ Test well ☐ Oil Rig

7 Casing: Material PVC Height: above/below
Threaded ☐ Welded ☐ Surface 28 in.
Diam. Weight 2.78 lbs./ft.
5 in. to 250 ft. depth Drive shoe? ☐ Yes ☒ No
5 in. to 300 ft. depth

2

Type and color of material	From	To
Surface	0	2
Sandy clay	2	110
Coarse sand	110	300
(use a second sheet if needed)		

8 Screen:
Manufacturer Wesco
Type PVC Dia. 5
Slot/gauze .030 Length 10
Set between 250 ft. and 260 ft.
Fittings: 1/8 to 3/16
Gravel pack ☒ Yes ☐ No Size range of material

9 Static water level:
210 ft. below land surface Date 5-31-75

10 Pumping level below land surfaces:
ft. after hrs. pumping g.p.m.
ft. after hrs. pumping g.p.m.
Estimated maximum yield 35 g.p.m.

11 Water sample submitted:
☐ Yes ☒ No Date

12 Well head completion:
☐ Pitless adapter 28 Inches above grade

13 Well grouted? ☒ Yes ☐ No
☒ Neat cement ☐ Bentonite ☐
Depth: From 0 ft. to 10 ft.

14 Nearest source of possible contamination: Oil Well
ft. 100 Direction NE Type
Well disinfected upon completion? ☒ Yes ☐ No

15 Pump: ☒ Not installed
Manufacturer's name
Model number HP Volts
Length of drop pipe ft. capacity g.m.p.
Type:
☐ Submersible ☐ Turbine
☐ Jet ☐ Reciprocating
☐ Certrifugal ☐ Other

16 Remarks: elevation

Topography:
☐ Hill
☐ Slope
☒ Upland
☐ Valley

17 Water well contractor's certification:
This well was drilled under my jurisdiction and this report is true to the best of my knowledge and belief.
Carlile Water Well 118
Business name License No.
Address Box 275, Liberal, Kansas
Signed Edward E. Meeno Date 2-5-75
Authorized representative

32 S 32 W 23 CSWNW

Forward the white, blue and pink copies to the Kansas State Dept. Of Health.

Form WWC-5