


1 LOCATION OF WATER WELL: County: SEWARD Fraction SE 1/4 SE 1/4 NE 1/4 Section Number 29 Township Number T 32 S Range Number R 32 EW

Distance and direction from nearest town or city street address of well if located within city?  
6 3/4 MILES NW KISMET, KS

2 WATER WELL OWNER: CLYDE M. BECKER OIL #1 KANE  
RR#, St. Address, Box #: 212 FIRST NATIONAL BLDG. Board of Agriculture, Division of Water Resources  
City, State, ZIP Code: PONCA CITY, OK 74601 Application Number: 930324

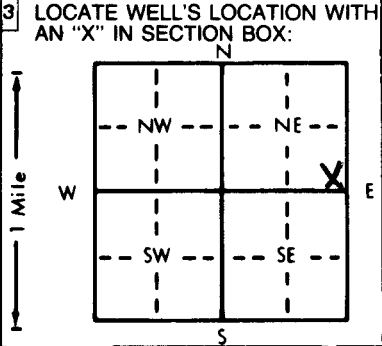

4 DEPTH OF COMPLETED WELL: 360 ft. ELEVATION:  
Depth(s) Groundwater Encountered 1. 215 ft. 2. ft. 3. ft.  
WELL'S STATIC WATER LEVEL: 215 ft. below land surface measured on mo/day/yr 8-31-93  
Pump test data: Well water was 240 ft. after 1 hours pumping 100 gpm  
Est. Yield 100 gpm: Well water was ft. after hours pumping gpm  
Bore Hole Diameter 11 in. to 360 ft., and in. to ft.  
WELL WATER TO BE USED AS:  
5 Public water supply 8 Air conditioning 11 Injection well  
1 Domestic 3 Feedlot 6 Oil field water supply 9 Dewatering 12 Other (Specify below)  
2 Irrigation 4 Industrial 7 Lawn and garden only 10 Monitoring well  
Was a chemical/bacteriological sample submitted to Department? Yes No x; If yes, mo/day/yr sample was submitted  
Water Well Disinfected? Yes x No

5 TYPE OF BLANK CASING USED:  
1 Steel 3 RMP (SR) 5 Wrought iron 8 Concrete tile CASING JOINTS: Glued x Clamped  
2 PVC 4 ABS 6 Asbestos-Cement 9 Other (specify below) Welded  
7 Fiberglass Threaded  
Blank casing diameter 6 in. to 360 ft., Dia. in. to ft., Dia. in. to ft.  
Casing height above land surface 24 in., weight 2.902 lbs./ft. Wall thickness or gauge No. 280 SDR 21  
TYPE OF SCREEN OR PERFORATION MATERIAL:  
1 Steel 3 Stainless steel 5 Fiberglass 7 PVC 10 Asbestos-cement  
2 Brass 4 Galvanized steel 6 Concrete tile 8 RMP (SR) 11 Other (specify)  
9 ABS 12 None used (open hole)  
SCREEN OR PERFORATION OPENINGS ARE:  
1 Continuous slot 3 Mill slot 5 Gauzed wrapped 8 Saw cut 11 None (open hole)  
2 Louvered shutter 4 Key punched 6 Wire wrapped 9 Drilled holes  
7 Torch cut 10 Other (specify)  
SCREEN-PERFORATED INTERVALS: From 280 ft. to 360 ft., From ft. to ft.  
GRAVEL PACK INTERVALS: From 240 ft. to 360 ft., From ft. to ft.

6 GROUT MATERIAL: 1 Neat cement 2 Cement grout 3 Bentonite 4 Other HOLE PLUG  
Grout Intervals: From 1 ft. to 20 ft., From ft. to ft., From ft. to ft.  
What is the nearest source of possible contamination:  
1 Septic tank 4 Lateral lines 7 Pit privy 10 Livestock pens 14 Abandoned water well  
2 Sewer lines 5 Cess pool 8 Sewage lagoon 11 Fuel storage 15 Oil well/Gas well  
3 Watertight sewer lines 6 Seepage pit 9 Feedyard 12 Fertilizer storage 16 Other (specify below)  
13 Insecticide storage  
Direction from well? SOUTH How many feet? 300

FROM	TO	LITHOLOGIC LOG	FROM	TO	PLUGGING INTERVALS
0	3	BROWN CLAY			
3	56	TAN CLAY			
56	75	SANDY CLAY			
75	186	SAND			
186	193	SMALL GRAVEL			
193	357	SAND			
357	360	SAND W/ CLAY STREAKS			

7 CONTRACTOR'S OR LANDOWNER'S CERTIFICATION: This water well was 1 constructed, (2) reconstructed, or (3) plugged under my jurisdiction and was completed on (mo/day/year) 8-31-93 and this record is true to the best of my knowledge and belief. Kansas Water Well Contractor's License No. KWWCL-430 This Water Well Record was completed on (mo/day/yr) 8-31-93 under the business name of HOWARD DRLG.CO. BOX 806 BEAVER, OK 73932 by (signature)

INSTRUCTIONS: Use typewriter or ball point pen. PLEASE PRESS FIRMLY and PRINT clearly. Please fill in blanks, underline or circle the correct answers. Send top three copies to Kansas Department of Health and Environment, Bureau of Water, Topeka, Kansas 66620-0001. Telephone: 913-296-5545. Send one to WATER WELL OWNER and retain one for your records.