


USE TYPEWRITER OR BALL POINT PEN—PRESS FIRMLY, PRINT CLEARLY.

WATER WELL RECORD
KSA 82a-1201-1215

Kansas Department of Health and Environment—Division of Environment
(Water well Contractors)
Topeka, Kansas 66620

1. Location of well:	County Seward	Fraction SE 1/4 SE 1/4 NW 1/4	Section number 29	Township number T 32 S R 32 E/W	Range number
----------------------	-------------------------	---	-----------------------------	--	--------------

2. Distance and direction from nearest town or city: Liberal, Kansas Street address of well location if in city:	3. Owner of well: Art Alexander R.R. or street: 1801 N. Cain City, state, zip code: Liberal, Kansas
---	---

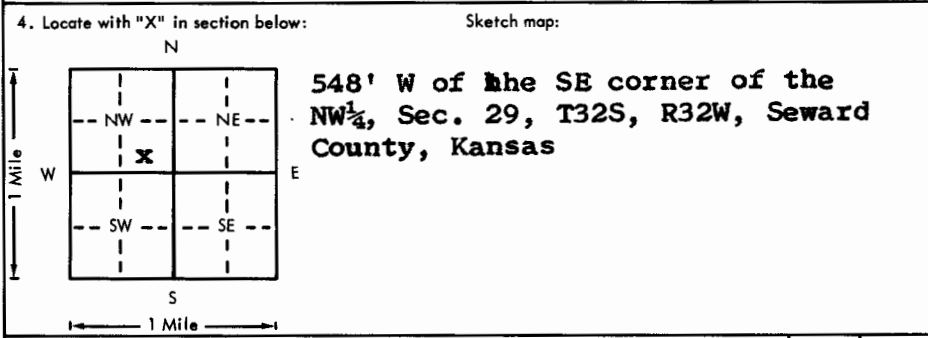

6. Bore hole dia. 28 in. Completion date 8-27-76
Well depth 408 ft.

7. Cable tool Rotary Driven Dug
 Hollow rod Jetted Bored Reverse rotary

8. Use: Domestic Public supply Industry
 Irrigation Air conditioning Stock
 Lawn Oil field water Other

9. Casing: Material Stl Height: Above or below
Threaded Welded Surface 12 in.
RMP PVC Weight 37 lbs./ft.
Dia. 16 in. to 187 ft. depth Wall Thickness: inches or
Dia. in. to ft. depth gage No. .219

5. Type and color of material	From	To
Fine sand	0	13
Tan clay	13	30
Tan sandy clay	30	53
Fine to medium sand	53	71
Tan sandy clay	71	94
Fine to medium sand clay streaks	94	475
Red bed	475	500
(Use a second sheet if needed)		

10. Screen: Manufacturer's name Foster, Doerr
Louver, Millslot 16"
Type 1/8" Dia. 221
Slot/gauze 187 Length 408
Set between ft. and ft.
Gravel pack? Size range of material 4.4 mm

11. Static water level: 190 ft. below land surface Date 6-23-76
mo./day/yr.

12. Pumping level below land surfaces:
208 ft. after 2 hrs. pumping 1100 g.p.m.
224 ft. after 1 hrs. pumping 1809 g.p.m.
Estimated maximum yield 1800 g.p.m.

13. Water sample submitted: mo./day/yr.
Yes No Date

14. Well head completion:
 Pitless adapter Inches above grade

15. Well grouted? Yes
With: Neat cement Bentonite Concrete
Depth: From 0 ft. to 10 ft.

16. Nearest source of possible contamination: unk
ft. Direction Type
Well disinfected upon completion? Yes No

17. Pump: Not installed
Manufacturer's name Layne & Bowler
Model number 12 KBH HP 200 Volts
Length of drop pipe 280 ft. capacity 700 g.p.m.
Type:
 Submersible Turbine
 Jet Reciprocating
 Centrifugal Other

18. Elevation:	19. Remarks:
Topography: <input type="checkbox"/> Hill <input type="checkbox"/> Slope <input checked="" type="checkbox"/> Upland <input type="checkbox"/> Valley	

20. Water well contractor's certification:
This well was drilled under my jurisdiction and this report is true to the best of my knowledge and belief.
Layne-Western Co., Inc 102
Business name Garden City, Kansas License No.
Address
Signed R. Vincent Date 1 Dec 76
Authorized representative

76
32
32
29
SE
1/4
1/4
1/4

Forward the white, blue and pink copies to the Department of Health and Environment

Form WWC-5