


1 LOCATION OF WATER WELL:		Fraction	Section Number	Township Number	Range Number
County:	Seward	C 1/4 NW 1/4 SE 1/4	11	T 32 S	R 32 E NW

Distance and direction from nearest town or city street address of well if located within city?

11 Miles West, 1/4 Mile No. of Plains

2	WATER WELL OWNER:	Pauline Douglas	Murfin Drilling, Inc.	
	RR#, St. Address, Box # :	721 N. Jordon	Box 661	Board of Agriculture, Division of Water Resources
	City, State, ZIP Code :	Liberal, Ks. 67901	Colby, Ks. 67701	Application Number: 940233

3 LOCATE WELL'S LOCATION WITH AN "X" IN SECTION BOX: 4 DEPTH OF COMPLETED WELL 360 ft. ELEVATION:

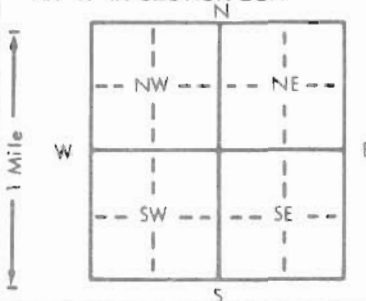

4) DEPTH OF COMPLETED WELL 360 ft. ELEVATION: _____

Depth(s) Groundwater Encountered 1. _____ ft. 2. _____ ft. 3. _____ ft.

WELL'S STATIC WATER LEVEL 220 ft. below land surface measured on mo/day/yr _____

Pump test data: Well water was _____ ft. after _____ hours pumping _____ gpm

Est. Yield _____ gpm: Well water was _____ ft. after _____ hours pumping _____ gpm

Bore Hole Diameter: _____ in. to _____ ft., and _____ in. to _____ ft.

WELL WATER TO BE USED AS:

1 Domestic	3 Feedlot	5 <u>Oil field water supply</u>	8 Air conditioning	11 Injection well
2 Irrigation	4 Industrial	6 <u>Lawn and garden only</u>	9 Dewatering	12 Other (Specify below)

Was a chemical/bacteriological sample submitted to Department? Yes _____ No ☒ _____ If yes, mo/day/yr sample was submitted _____

Water Well Disinfected? Yes _____ No ☒ _____

5	TYPE OF BLANK CASING USED:			5 Wrought iron	8 Concrete tile	CASING JOINTS: Glued <input type="checkbox"/> Clamped <input type="checkbox"/> Welded <input type="checkbox"/> Threaded <input type="checkbox"/>
	1 Steel	3 RMP (SR)	6 Asbestos-Cement	9 Other (specify below)		
	2 PVC	4 ABS	7 Fiberglass			

Blank casing diameter in. to ft. Dia in. to ft. Dia in. to ft.
Casing height above land surface -36 in. weight lbs./ft. Wall thickness or gauge No.

TYPE OF SCREEN OR PERFORATION MATERIAL:			7 PVC	10 Asbestos-cement
1 Steel	3 Stainless steel	5 Fiberglass	8 RMP (SR)	11 Other (specify) NA
2 Brass	4 Galvanized steel	6 Concrete tile	9 ABS	12 None used (open note)

SCREEN OR PERFORATION OPENINGS ARE:

1 Continuous slot	3 Mill slot	5 Gauzed wrapped	8 Saw cut	11 None (open hole)
2 Louvered shutter	4 Key punched	6 Wire wrapped	9 Drilled holes	
		7 Torch cut	10 Other (specify) _____	NA

SCREEN-PERFORATED INTERVALS:		From	ft. to	ft.	From	ft. to	ft.
		NA			NA		
		From	ft. to	ft.	From	ft. to	ft.
GRAVEL PACK INTERVALS:		From	ft. to	ft.	From	ft. to	ft.
		From	ft. to	ft.	From	ft. to	ft.

6 GROUT MATERIAL: 1 Neat cement 2 Cement grout 3 Bentonite 4 Other

Grout intervals: From 6 ft to 3 ft From ft to ft From ft to ft

What is the nearest source of possible contamination:

1 Septic tank	4 Lateral lines	7 Pit privy	10 Livestock pens	14 Abandoned water well
2 Sewer lines	5 Cess pool	8 Sewage lagoon	11 Fuel storage	15 Oil well/Gas well
3 Watertight sewer lines	6 Seepage pit	9 Feedyard	12 Fertilizer storage	16 Other (specify below)
			13 Insecticide storage	None

Direction from well? _____ How many feet? _____

[illegible]

7. CONTRACTOR'S OR LANDOWNER'S CERTIFICATION: This water well was (1) constructed, (2) reconstructed, or (3) plugged under my jurisdiction and was completed on (mo/day/year) **8-29-94** and this record is true to the best of my knowledge and belief. Kansas Water Well Contractor's License No. **554** This Water Well Record was completed on (mo/day/yr) **9-28-94** under the business name of **Woofter Pump & Well, Inc.** by (signature) *an e. woofter*