


1 LOCATION OF WATER WELL: Fraction NW 1/4 SE 1/4 NW 1/4 Section Number 8 Township Number T 32 S Range Number R 33 EW

Distance and direction from nearest town or city street address of well if located within city?

14 3/4 North 1 West of Liberal, KS

2 WATER WELL OWNER: #1 Morgan I Gabbert & Jones  
 RR#, St. Address, Box #: 333 E. English Ste 215 Board of Agriculture, Division of Water Resources  
 City, State, ZIP Code: Wichita, KS 67202 Application Number: T88-613

3 LOCATE WELL'S LOCATION WITH AN "X" IN SECTION BOX:

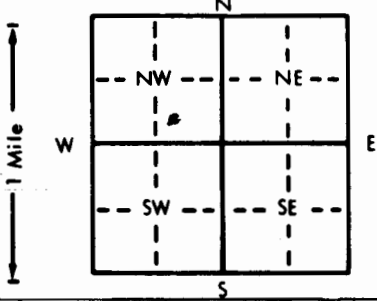

4 DEPTH OF COMPLETED WELL: 280 ft. ELEVATION: ..... ft.  
 Depth(s) Groundwater Encountered 1... 100 ft. 2..... ft. 3..... ft.  
 WELL'S STATIC WATER LEVEL .. 180 ft. below land surface measured on mo/day/yr .. 12-19-88  
 Pump test data: Well water was .165 ft. after ..... 2 hours pumping ... 65 gpm  
 Est. Yield ... 70 gpm: Well water was ..... ft. after ..... hours pumping ..... gpm  
 Bore Hole Diameter: ... 9 in. to ... 280 ft., and ..... in. to ..... ft.  
 WELL WATER TO BE USED AS: 5 Public water supply 8 Air conditioning 11 Injection well  
 1 Domestic 3 Feedlot 6 Oil field water supply 9 Dewatering 12 Other (Specify below)  
 2 Irrigation 4 Industrial 7 Lawn and garden only 10 Monitoring well  
 Was a chemical/bacteriological sample submitted to Department? Yes.....No X.....; If yes, mo/day/yr sample was submitted  
 Water Well Disinfected? Yes X No

5 TYPE OF BLANK CASING USED: 5 Wrought iron 8 Concrete tile CASING JOINTS: Glued X Clamped  
 1 Steel 3 RMP (SR) 6 Asbestos-Cement 9 Other (specify below) Welded  
 2 PVC 4 ABS 7 Fiberglass Threaded  
 Blank casing diameter ... 5 in. to ... 0-180 ft., Dia ..... in. to ..... ft., Dia ..... in. to ..... ft.  
 Casing height above land surface: ... 14 in., weight 200 lbs./ft. Wall thickness or gauge No. 0.265

TYPE OF SCREEN OR PERFORATION MATERIAL: 7 PVC 10 Asbestos-cement  
 1 Steel 3 Stainless steel 5 Fiberglass 8 RMP (SR) 11 Other (specify)  
 2 Brass 4 Galvanized steel 6 Concrete tile 9 ABS 12 None used (open hole)

SCREEN OR PERFORATION OPENINGS ARE: 5 Gauzed wrapped 8 Saw cut 11 None (open hole)  
 1 Continuous slot 3 Mill slot 6 Wire wrapped 9 Drilled holes  
 2 Louvered shutter 4 Key punched 7 Torch cut 10 Other (specify)

SCREEN-PERFORATED INTERVALS: From ... 180 ft. to ... 280 ft., From ..... ft. to ..... ft.  
 GRAVEL PACK INTERVALS: From ... 105 ft. to ... 280 ft., From ..... ft. to ..... ft.

6 GROUT MATERIAL: 1 Neat cement 2 Cement grout 3 Bentonite 4 Other  
 Grout Intervals: From 0 ft. to 20 ft., From ..... ft. to ..... ft., From ..... ft. to ..... ft.  
 What is the nearest source of possible contamination: 10 Livestock pens 14 Abandoned water well  
 1 Septic tank 4 Lateral lines 7 Pit privy 11 Fuel storage 15 Oil well/Gas well  
 2 Sewer lines 5 Cess pool 8 Sewage lagoon 12 Fertilizer storage 16 Other (specify below)  
 3 Watertight sewer lines 6 Seepage pit 9 Feedyard 13 Insecticide storage  
 Direction from well? Southwest How many feet? 250

| FROM | TO  | LITHOLOGIC LOG        | FROM | TO | PLUGGING INTERVALS |
|------|-----|-----------------------|------|----|--------------------|
| 0    | 180 | Overburden            |      |    |                    |
| 180  | 200 | Medium sand           |      |    |                    |
| 200  | 220 | Medium to coarse sand |      |    |                    |
| 220  | 240 | Medium sand           |      |    |                    |
| 240  | 260 | Medium sand           |      |    |                    |
| 260  | 280 | Fine sand             |      |    |                    |

7 CONTRACTOR'S OR LANDOWNER'S CERTIFICATION: This water well was (1) constructed, (2) reconstructed, or (3) plugged under my jurisdiction and was completed on (mo/day/year) 12-19-88 and this record is true to the best of my knowledge and belief. Kansas Water Well Contractor's License No. 142 This Water Well Record was completed on (mo/day/yr) 12-27-88 under the business name of T & W Water Well Service, Inc. by (signature) CD Wagoner