

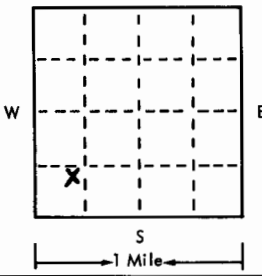
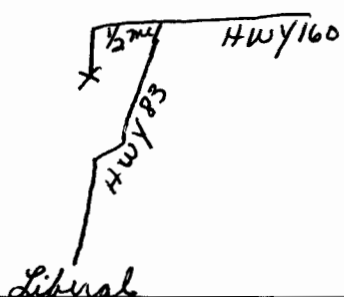
USE TYPEWRITER OR BALL POINT PEN-PRESS FIRMLY, PRINT CLEARLY.

T R EW sec 1/4 1/4 1/4 No.

WATER WELL RECORD  
KSA 82a-1201-1215

Kansas State Dept. Of Health  
(Water Well Contractors)  
Forbes-Bldg. 740  
Topeka, Kansas 66620

**LaMert-Trent 2-14 CWW Inv. 111427**

1 Location of well:	County <b>Seward</b>	Township name	Fraction <b>NE SW SW</b>	Section number <b>14</b>	Town number <b>32S</b>	Range number <b>33W</b>
Distance and direction from nearest town or city: <b>16 mile North of Liberal to 83-160 JCT, 1/2 West, 3/4 South</b> Street address of well location if in city:				3 Owner of well: <b>Unit Drilling Company Rig. 1</b> Address: <b>1101 Petroleum Club Bldg. Tulsa, Oklahoma 74119</b>		
Locate with "X" in section below: N  W E S 1 Mile		Sketch map: 		4 Well depth: <b>200</b> ft. Date of completion: <b>6-18-75</b> Well diameter <b>9</b> in.		
				5 <input type="checkbox"/> Cable tool <input checked="" type="checkbox"/> Rotary <input type="checkbox"/> Driven <input type="checkbox"/> Dug <input type="checkbox"/> Hollow rod <input type="checkbox"/> Jetted <input type="checkbox"/> Bored <input type="checkbox"/> Reverse rotary		
				6 Use: <input type="checkbox"/> Domestic <input type="checkbox"/> Public supply <input checked="" type="checkbox"/> Industry <input type="checkbox"/> Irrigation <input type="checkbox"/> Air conditioning <input type="checkbox"/> Commercial <input type="checkbox"/> Test well <input type="checkbox"/> <b>Oil Rig</b>		
				7 Casing: Material <b>PVC</b> Height: above/below Threaded <input type="checkbox"/> Welded <input type="checkbox"/> Surface <b>28</b> in. Diam. Weight <b>2.78</b> lbs./ft. <b>5</b> in. to <b>150</b> ft. depth! Drive shoe? <input type="checkbox"/> Yes <input checked="" type="checkbox"/> No <b>5</b> in. to <b>200</b> ft. depth!		
2 Type and color of material		From	To	8 Screen: Manufacturer <b>Wesco</b> Type <b>PVC</b> Dia. <b>5 1/2</b> Slot/gauze <b>.030</b> Length <b>10'</b> Set between <b>150</b> ft. and <b>160</b> ft. Fittings: <b>1/8 - 3/16</b> Gravel pack <input type="checkbox"/> Yes <input type="checkbox"/> No Size range of material		
<b>Surface</b>		<b>0-3</b>	<b>2</b>	9 Static water level: <b>100</b> ft. below land surface Date <b>6-18-75</b>		
<b>Sandy Clay</b>		<b>2</b>	<b>35</b>	10 Pumping level below land surfaces: ____ ft. after ____ hrs. pumping ____ g.p.m. ____ ft. after ____ hrs. pumping ____ g.p.m. Estimated maximum yield <b>45</b> g.p.m.		
<b>Medium to large sand</b>		<b>35</b>	<b>200</b>	11 Water sample submitted: <input type="checkbox"/> Yes <input checked="" type="checkbox"/> No Date		
				12 Well head completion: <input type="checkbox"/> Pitless adapter <b>28</b> Inches above grade		
				13 Well grouted? <input checked="" type="checkbox"/> Yes <input type="checkbox"/> No <input checked="" type="checkbox"/> Neat cement <input type="checkbox"/> Bentonite <input type="checkbox"/> Depth: From <b>0</b> ft. to <b>10</b> ft.		
				14 Nearest source of possible contamination: ft. <b>150</b> Direction <b>West</b> Type <b>Oil well</b> Well disinfected upon completion? <input checked="" type="checkbox"/> Yes <input type="checkbox"/> No		
				15 Pump: <input checked="" type="checkbox"/> Not installed Manufacturer's name Model number ____ HP ____ Volts ____ Length of drop pipe ____ ft. capacity ____ g.m.p. Type: <input type="checkbox"/> Submersible <input type="checkbox"/> Turbine <input type="checkbox"/> Jet <input type="checkbox"/> Reciprocating <input type="checkbox"/> Centrifugal <input type="checkbox"/> Other		
16 Remarks: elevation		(use a second sheet if needed)		17 Water well contractor's certification: This well was drilled under my jurisdiction and this report is true to the best of my knowledge and belief. <b>Carlile Water Well Serv. 118</b> Business name License No. Address <b>Box 275, Liberal, Ks.</b> Signed <b>Edward E. Mean</b> Date <b>6-18-75</b> Authorized representative		
Topography: <input type="checkbox"/> Hill <input type="checkbox"/> Slope <input checked="" type="checkbox"/> Upland <input type="checkbox"/> Valley						

32 33W 14 NE SW SW