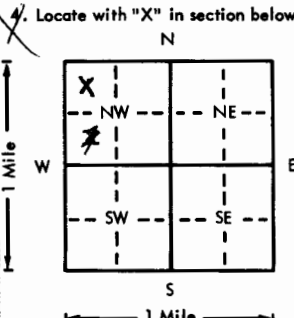


USE TYPEWRITER OR BALL
POINT PEN-PRESS FIRMLY,
PRINT CLEARLY.

WATER WELL RECORD
KSA 82a-1201-1215

Kansas Department of Health and
Environment-Division of Environment
(Water well Contractors)
Topeka, Kansas 66620

1. Location of well:		County Seward	Section 1/4 NW 1/4 NW 1/4	Section number 15	Township number T 32 S R 33 E/W	Range number
2. Distance and direction from nearest town or city: 18 mi. North on Hwy. 83, - 3 mi. We. - South side of road.			3. Owner of well: Supreme Feeders, Inc. R.R. or street: P.O. Box 606 City, state, zip code: Liberal, Kansas 67901			
4. Locate with "X" in section below: 			6. Bore hole dia. 12 in. Completion date 7/27 Well depth 300 ft.			
5. Type and color of material			7. Cable tool <input checked="" type="checkbox"/> Rotary <input type="checkbox"/> Driven <input type="checkbox"/> Dug <input type="checkbox"/> Hollow rod <input type="checkbox"/> Jetted <input type="checkbox"/> Bored <input type="checkbox"/> Reverse rotary			
Surface			8. Use: <input checked="" type="checkbox"/> Domestic <input type="checkbox"/> Public supply <input checked="" type="checkbox"/> Industry <input type="checkbox"/> Irrigation <input type="checkbox"/> Air conditioning <input type="checkbox"/> Stock <input type="checkbox"/> Lawn <input type="checkbox"/> Oil field water <input type="checkbox"/> Other			
Sandy Clay			9. Casing: Material <input type="checkbox"/> Height: Above or below Threaded <input type="checkbox"/> Welded <input type="checkbox"/> Surface 28 in. RMP <input type="checkbox"/> PVC <input checked="" type="checkbox"/> Weight 2.78 lbs./ft. Dia. 6 in. to 250 ft. depth Wall Thickness: inches or Dia. 6 in. to 300 ft. depth gage No. 265			
Med. to large sand			10. Screen: Manufacturer's name Wesco Sawed Perf. - Screen Type PVC Dia. 6 1/2 Slot/gauze 0.30 Length 40' Set between 250 ft. and 290 ft. ft. and 290 ft. Gravel pack? yes Size range of material 1/8-3/16			
			11. Static water level: 167 ft. below land surface Date 7/27/76 mo./day/yr.			
			12. Pumping level below land surfaces: ft. after 50 hrs. pumping 50 g.p.m. ft. after 50 hrs. pumping 50 g.p.m. Estimated maximum yield 50 g.p.m.			
			13. Water sample submitted: Yes <input checked="" type="checkbox"/> No <input type="checkbox"/> Date 7/27/76 mo./day/yr.			
			14. Well head completion: <input type="checkbox"/> Pitless adapter 28 inches above grade			
			15. Well grouted? yes With: <input checked="" type="checkbox"/> Neat cement <input type="checkbox"/> Bentonite <input type="checkbox"/> Concrete Depth: From 0 ft. to 10 ft.			
			16. Nearest source of possible contamination: ft. 0 Direction W Type W Well disinfected upon completion? <input checked="" type="checkbox"/> Yes <input type="checkbox"/> No			
			17. Pump: Manufacturer's name Sta-rite Not installed Model number 140 PLJ2 HP 5 Volts 230 Length of drop pipe 240 ft. capacity 60 g.p.m. Type: <input checked="" type="checkbox"/> Submersible <input type="checkbox"/> Turbine <input type="checkbox"/> Jet <input type="checkbox"/> Reciprocating <input type="checkbox"/> Centrifugal <input type="checkbox"/> Other			
18. Elevation:			20. Water well contractor's certification: This well was drilled under my jurisdiction and this report is true to the best of my knowledge and belief. Carlile Water Well Service, 118 Business name License No. Address Box 275, Liberal, Ks. Signed Edward E. Mann Date 8/11 Authorized representative			
19. Remarks:						
Topography: <input type="checkbox"/> Hill <input type="checkbox"/> Slope <input checked="" type="checkbox"/> Upland <input type="checkbox"/> Valley						

Forward the white, blue and pink copies to the Department of Health and Environment

Form WWC-5