


1 LOCATION OF WATER WELL: Fraction $\frac{1}{4}$ C/SW $\frac{1}{4}$ SW $\frac{1}{4}$ Section Number 19 Township Number T 32 **S** Range Number R 33 **E W**
 County: Seward

Distance and direction from nearest town or city street address of well if located within city?
 14N of Liberal, KS

2 WATER WELL OWNER: Cabot Oil & Gas #1-19 Hitch
 RR#, St. Address, Box #: 9400 N Broadway, Suite 608 Board of Agriculture, Division of Water Resources
 City, State, ZIP Code: Oklahoma City, OK 73114 Application Number: Cabot Permitted

3 LOCATE WELL'S LOCATION WITH AN "X" IN SECTION BOX:

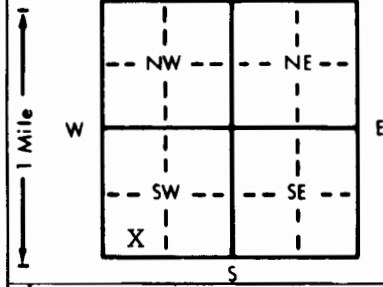

4 DEPTH OF COMPLETED WELL: 280 ft. ELEVATION:
 Depth(s) Groundwater Encountered 1. 100 ft. 2. ft. 3. ft.
 WELL'S STATIC WATER LEVEL: 100 ft. below land surface measured on mo/day/yr 12/29/92
 Pump test data: Well water was 200 ft. after 1 hours pumping 100 gpm
 Est. Yield 100 gpm: Well water was ft. after hours pumping gpm
 Bore Hole Diameter: in. to ft., and in. to ft.
 WELL WATER TO BE USED AS:
 1 Domestic 3 Feedlot **6** Oil field water supply 9 Dewatering 12 Other (Specify below)
 2 Irrigation 4 Industrial 7 Lawn and garden only 10 Monitoring well
 Was a chemical/bacteriological sample submitted to Department? Yes.....No...**X**.....; If yes, mo/day/yr sample was submitted
 Water Well Disinfected? Yes **X** No

5 TYPE OF BLANK CASING USED:
 1 Steel 3 RMP (SR) 5 Wrought iron 8 Concrete tile CASING JOINTS: Glued **X** Clamped
2 PVC 4 ABS 6 Asbestos-Cement 9 Other (specify below) Welded
 7 Fiberglass Threaded

Blank casing diameter 5 in. to 280 ft., Dia. in. to ft., Dia. in. to ft.
 Casing height above land surface 24 in., weight 2,902 lbs./ft. Wall thickness or gauge No. 280 SDR21

TYPE OF SCREEN OR PERFORATION MATERIAL:
 1 Steel 3 Stainless steel 5 Fiberglass **7** PVC 10 Asbestos-cement
 2 Brass 4 Galvanized steel 6 Concrete tile 9 ABS 11 Other (specify)
 12 None used (open hole)

SCREEN OR PERFORATION OPENINGS ARE:
 1 Continuous slot 3 Mill slot 5 Gauzed wrapped **8** Saw cut 11 None (open hole)
 2 Louvered shutter 4 Key punched 6 Wire wrapped 9 Drilled holes
 7 Torch cut 10 Other (specify)

SCREEN-PERFORATED INTERVALS: From 180 ft. to 280 ft., From ft. to ft.
 GRAVEL PACK INTERVALS: From 80 ft. to 280 ft., From ft. to ft.

6 GROUT MATERIAL: **1** Neat cement 2 Cement grout 3 Bentonite **4** Other... Hole Plug
 Grout intervals: From 1 ft. to 20 ft., From ft. to ft., From ft. to ft.

What is the nearest source of possible contamination:
 1 Septic tank 4 Lateral lines 7 Pit privy 10 Livestock pens 14 Abandoned water well
 2 Sewer lines 5 Cess pool 8 Sewage lagoon 11 Fuel storage **15** Oil well/Gas well
 3 Watertight sewer lines 6 Seepage pit 9 Feedyard 12 Fertilizer storage 16 Other (specify below)
 13 Insecticide storage

Direction from well? Southeast How many feet? 230

FROM	TO	LITHOLOGIC LOG	FROM	TO	PLUGGING INTERVALS
0	1	Surface Soil			
1	18	Sandy Clay			
18	23	Sand			
23	54	Clay			
54	74	Sand			
74	92	Clay			
92	250	Sand & Gravel			
250	262	Sand & Clay			
262	280	Clay			

7 CONTRACTOR'S OR LANDOWNER'S CERTIFICATION: This water well was **1** constructed, (2) reconstructed, or (3) plugged under my jurisdiction and was completed on (mo/day/year) 12/29/92 and this record is true to the best of my knowledge and belief. Kansas Water Well Contractor's License No. KWCL-430 This Water Well Record was completed on (mo/day/yr) 12/29/92 under the business name of Howard Drlg. Co., Box 806 Beaver, OK 73932 by (signature) *Howard Drlg. Co.*

INSTRUCTIONS: Use typewriter or ball point pen. PLEASE PRESS FIRMLY and PRINT clearly. Please fill in blanks, underline or circle the correct answers. Send top three copies to Kansas Department of Health and Environment, Bureau of Water, Topeka, Kansas 66620-0001. Telephone: 913-296-5545. Send one to WATER WELL OWNER and retain one for your records.