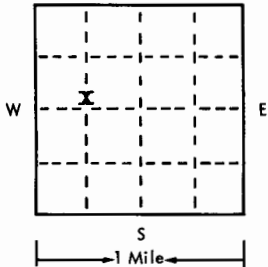
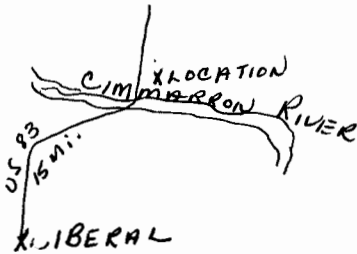


USE TYPEWRITER OR BALL
POINT PEN-PRESS FIRMLY,
PRINT CLEARLY.

WATER WELL RECORD
KSA 82a-1201-1215

T R EW sec 1/4 1/4 1/4 No.

Kansas State Dept. Of Health
(Water Well Contractors)
Forbes-Bldg. 740
Topeka, Kansas 66620

1 Location of well:	County Seward	Township name	Fraction C SW	Section number 25	Town number 32S	Range number 33W
Distance and direction from nearest town or city: 15 miles north of Liberal Street address of well location if in city:				3 Owner of well: Don Kane Address: RFD Kismet, Kansas 67901		
Locate with "X" in section below: 				Sketch map: 		
2				4 Well depth: 230 ft. Date of completion 9-11-75 Well diameter 28 in.		
Type and color of material				5 <input type="checkbox"/> Cable tool <input checked="" type="checkbox"/> Rotary <input type="checkbox"/> Driven <input type="checkbox"/> Dug <input type="checkbox"/> Hollow rod <input type="checkbox"/> Jetted <input type="checkbox"/> Bored <input type="checkbox"/> Reverse rotary		
Clay				6 Use: <input type="checkbox"/> Domestic <input type="checkbox"/> Public supply <input type="checkbox"/> Industry <input checked="" type="checkbox"/> Irrigation <input type="checkbox"/> Air conditioning <input type="checkbox"/> Commercial <input type="checkbox"/> Test well <input type="checkbox"/>		
Fine sand and Coarse sand 50-50				7 Casing: Material steel Height: above/below Threaded <input type="checkbox"/> Welded <input type="checkbox"/> Surface 28 in. Diam. 16 in. to 100 ft. depth! Weight 42.05 lbs./ft. 16 in. to 230 ft. depth! Drive shoe? <input type="checkbox"/> Yes <input checked="" type="checkbox"/> No		
Fine sand and gravel 80-20				8 Screen: Manufacturer Doerr Type steel Dia. 16" Slot/gauze 3/32 Length 120 Set between 100 ft. and 220 ft. Fittings: 1/8 to 3/16 Gravel pack <input checked="" type="checkbox"/> Yes <input type="checkbox"/> No Size range of material —		
Coarse sand and gravel 70-30 loose drilling				9 Static water level: 47 ft. below land surface Date 9-11-75		
Fine sand				10 Pumping level below land surfaces: 71 ft. after 12 hrs. pumping 1000 g.p.m. 78 ft. after 24 hrs. pumping 1600 g.p.m. Estimated maximum yield 3500 g.p.m.		
Fine fine sand and coarse sand 50-50				11 Water sample submitted: <input type="checkbox"/> Yes <input checked="" type="checkbox"/> No Date —		
Coarse sand				12 Well head completion: <input type="checkbox"/> Pitless adapter 28 inches above grade		
Fine sand				13 Well grouted? <input checked="" type="checkbox"/> Yes <input type="checkbox"/> No <input checked="" type="checkbox"/> Neat cement <input type="checkbox"/> Bentonite <input type="checkbox"/> — Depth: From 0 ft. to 10 ft.		
Coarse sand				14 Nearest source of possible contamination: None ft. — Direction — Type — Well disinfected upon completion? <input checked="" type="checkbox"/> Yes <input type="checkbox"/> No		
Clay and coarse sand 50-50 loose drilling				15 Pump: <input type="checkbox"/> Not installed Manufacturer's name Goulds Model number 12JHO HP 75 Volts 1140 Length of drop pipe 100 ft. capacity 1200 g.p.m. Type: <input type="checkbox"/> Submersible <input checked="" type="checkbox"/> Turbine <input type="checkbox"/> Jet <input type="checkbox"/> Reciprocating <input type="checkbox"/> Centrifugal <input type="checkbox"/> Other		
Clay and coarse sand 50-50 loose drilling				17 Water well contractor's certification: This well was drilled under my jurisdiction and this report is true to the best of my knowledge and belief. Carlile Water Well 118 Business name Box 275, Liberal, Kansas License No. — Address — Signed Edward E Means date 9-9-75 Authorized representative		
Clay, fine sand, coarse sand 10-50-40						
Coarse sand						
Fine sand and coarse sand 50-50						
Fine sand						
(use a second sheet if needed)						
16 Remarks: elevation						
Topography: <input type="checkbox"/> Hill <input type="checkbox"/> Slope <input checked="" type="checkbox"/> Upland <input type="checkbox"/> Valley						