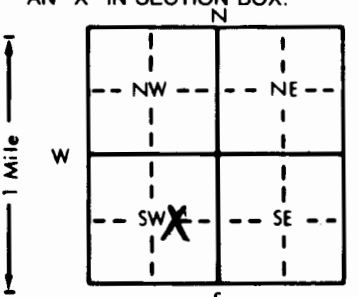


1 LOCATION OF WATER WELL: County: Seward Fraction: W 1/2 1/4 E 1/2 1/4 SW 1/4 Section Number: 29 Township Number: T 32 Range Number: R 33 **(S)** **(EW)**

Distance and direction from nearest town or city street address of well if located within city?
12 1/2 miles N of Liberal, KS--

2 WATER WELL OWNER: Cabot Petroleum Corp. #2-29 Naden
 RR#, St. Address, Box #: 9400 N Broadway, Ste. 608 Board of Agriculture, Division of Water Resources
 City, State, ZIP Code: Oklahoma City, OK 73114 Application Number: 91-0147

3 LOCATE WELL'S LOCATION WITH AN "X" IN SECTION BOX:

 4 DEPTH OF COMPLETED WELL: 300 ft. ELEVATION:
 Depth(s) Groundwater Encountered 1. 105 ft. 2. _____ ft. 3. _____ ft.
 WELL'S STATIC WATER LEVEL 105 ft. below land surface measured on mo/day/yr 03-22-91
 Pump test data: Well water was 118 ft. after 1 hours pumping 105 gpm
 Est. Yield 105 gpm: Well water was _____ ft. after _____ hours pumping _____ gpm
 Bore Hole Diameter: 9 1/2 in. to 300 ft., and _____ in. to _____ ft.
 WELL WATER TO BE USED AS:
 5 Public water supply 8 Air conditioning 11 Injection well
 1 Domestic 3 Feedlot **(6)** Oil field water supply 9 Dewatering 12 Other (Specify below)
 2 Irrigation 4 Industrial 7 Lawn and garden only 10 Monitoring well
 Was a chemical/bacteriological sample submitted to Department? Yes _____ No **(X)** _____; If yes, mo/day/yr sample was submitted
 Water Well Disinfected? Yes **(X)** No

5 TYPE OF BLANK CASING USED:
 1 Steel 3 RMP (SR) 5 Wrought iron 8 Concrete tile CASING JOINTS: Glued **(X)** Clamped _____
(2) PVC 4 ABS 6 Asbestos-Cement 9 Other (specify below) Welded _____
 7 Fiberglass Threaded _____
 Casing casing diameter 5 in. to 300 ft., Dia _____ in. to _____ ft., Dia _____ in. to _____ ft.
 Casing height above land surface 24 in., weight _____ lbs./ft. Wall thickness or gauge No. .032
 TYPE OF SCREEN OR PERFORATION MATERIAL:
 1 Steel 3 Stainless steel 5 Fiberglass **(7)** PVC 10 Asbestos-cement
 2 Brass 4 Galvanized steel 6 Concrete tile 8 RMP (SR) 11 Other (specify) _____
 9 ABS 12 None used (open hole)
 SCREEN OR PERFORATION OPENINGS ARE:
 1 Continuous slot 3 Mill slot 5 Gauzed wrapped **(8)** Saw cut 11 None (open hole)
 2 Louvered shutter 4 Key punched 6 Wire wrapped 9 Drilled holes
 7 Torch cut 10 Other (specify) _____
 SCREEN-PERFORATED INTERVALS: From 220 ft. to 300 ft., From _____ ft. to _____ ft.
 From _____ ft. to _____ ft., From _____ ft. to _____ ft.
 GRAVEL PACK INTERVALS: From 120 ft. to 300 ft., From _____ ft. to _____ ft.
 From _____ ft. to _____ ft., From _____ ft. to _____ ft.

6 GROUT MATERIAL: **(1)** Neat cement 2 Cement grout 3 Bentonite **(4)** Other Hole plug
 Grout Intervals: From 1 ft. to 20 ft., From _____ ft. to _____ ft., From _____ ft. to _____ ft.
 What is the nearest source of possible contamination:
 1 Septic tank 4 Lateral lines 7 Pit privy 10 Livestock pens 14 Abandoned water well
 2 Sewer lines 5 Cess pool 8 Sewage lagoon 11 Fuel storage **(15)** Oil well/Gas well
 3 Watertight sewer lines 6 Seepage pit 9 Feedyard 12 Fertilizer storage 16 Other (specify below)
 13 Insecticide storage
 Direction from well? Southeast How many feet? 180

FROM	TO	LITHOLOGIC LOG	FROM	TO	PLUGGING INTERVALS
0	3	Sand			
3	11	Clay sandy and Gravel			
11	30	Sandy Clay			
30	59	Sand and Gravel			
59	66	Sandy Clay			
66	300	Sand and Gravel			

7 CONTRACTOR'S OR LANDOWNER'S CERTIFICATION: This water well was **(1)** constructed, (2) reconstructed, or (3) plugged under my jurisdiction and was completed on (mo/day/year) 03-22-91 and this record is true to the best of my knowledge and belief. Kansas Water Well Contractor's License No. KWACL-430 This Water Well Record was completed on (mo/day/yr) 03-22-91 under the business name of Howard Drlg.Co. Box 806 Beaver, OK 73932 by (signature) *Howard Drlg. Co.*

INSTRUCTIONS: Use typewriter or ball point pen. PLEASE PRESS FIRMLY and PRINT clearly. Please fill in blanks, underline or circle the correct answers. Send top three copies to Kansas Department of Health and Environment, Bureau of Water, Topeka, Kansas 66620-7320. Telephone: 913-296-5545. Send one to WATER WELL OWNER and retain one for your records.