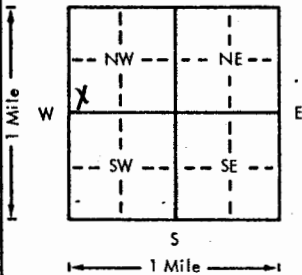


USE TYPEWRITER OR BALL POINT PEN-PRESS FIRMLY, PRINT CLEARLY.

WATER WELL RECORD  
KSA 82a-1201-1215

Kansas Department of Health and Environment-Division of Environment  
(Water well Contractors)  
Topeka, Kansas 66620

1. Location of well: County <b>SEWARD</b>		Fraction <b>SW<sub>1/4</sub> SW<sub>1/4</sub> NW<sub>1/4</sub></b>		Section number <b>30</b>		Township number <b>T 32 S</b>		Range number <b>R 33 EW</b>					
2. Distance and direction from nearest town or city: <b>11 m N Liberal 2 W 1/2 N</b>				3. Owner of well: <b>Hitch hand and Cattle</b> R.R. or street: <b>101 West 4th</b> City, state, zip code: <b>Liberal, Kansas 67901</b>									
4. Locate with "X" in section below: N W X E S 1 Mile				Sketch map: 		6. Bore hole dia. <b>9</b> in. Completion date <b>3/17</b> Well depth <b>340</b> ft.							
5. Type and color of material				From		To		7. <input type="checkbox"/> Cable tool <input checked="" type="checkbox"/> Rotary <input type="checkbox"/> Driven <input type="checkbox"/> Dug <input type="checkbox"/> Hollow rod <input type="checkbox"/> Jetted <input type="checkbox"/> Bored <input type="checkbox"/> Reverse rotary					
				overburden		0		145		8. Use: <input type="checkbox"/> Domestic <input type="checkbox"/> Public supply <input type="checkbox"/> Industry <input type="checkbox"/> Irrigation <input type="checkbox"/> Air conditioning <input checked="" type="checkbox"/> Stock <input type="checkbox"/> Lawn <input type="checkbox"/> Oil field water <input type="checkbox"/> Other			
				medium sand + clay streaks		145		200		9. Casing: Material <b>PVC</b> Height: <u>Above</u> or below Threaded <input type="checkbox"/> Welded <input type="checkbox"/> Surface <b>14</b> in. RMP <input type="checkbox"/> PVC <input checked="" type="checkbox"/> Weight <input type="checkbox"/> lbs./ft. Dia. <b>5</b> in. to <b>200</b> ft. depth Wall Thickness: inches or Dia. <input type="checkbox"/> in. to <input type="checkbox"/> ft. depth gage No. <b>0258</b>			
				medium to coarse sand		200		290		10. Screen: Manufacturer's name <b>Konestar</b> Type <b>PVC</b> Dia. <b>60</b> Slot/gauze <b>1/16</b> Length Set between <b>280</b> ft. and <b>340</b> ft. <input type="checkbox"/> ft. and <input type="checkbox"/> ft. Gravel pack? <b>Yes</b> Size range of material <b>1/8</b>			
				medium sand + clay		290		330		11. Static water level: <input type="checkbox"/> no./day/yr. <b>145</b> ft. below land surface Date <b>3/17/81</b>			
Blue clay		330		340		12. Pumping level below land surfaces: <input type="checkbox"/> ft. after <input type="checkbox"/> hrs. pumping <input type="checkbox"/> g.p.m. <input type="checkbox"/> ft. after <input type="checkbox"/> hrs. pumping <input type="checkbox"/> g.p.m. Estimated maximum yield <b>60</b> g.p.m.							
								13. Water sample submitted: <input type="checkbox"/> Yes <input checked="" type="checkbox"/> No Date <input type="checkbox"/>					
								14. Well head completion: <input type="checkbox"/> Pitless adapter <b>14</b> Inches above grade					
								15. Well grouted? <b>Yes</b> With: <input checked="" type="checkbox"/> Neat cement <input type="checkbox"/> Bentonite <input type="checkbox"/> Concrete Depth: From <b>3</b> ft. to <b>13</b> ft.					
								16. Nearest source of possible contamination: <b>None</b> ft. <input type="checkbox"/> Direction <input type="checkbox"/> Type <input type="checkbox"/> Well disinfected upon completion? <input type="checkbox"/> Yes <input checked="" type="checkbox"/> No					
								17. Pump: <input checked="" type="checkbox"/> Not installed Manufacturer's name <input type="checkbox"/> Model number <input type="checkbox"/> HP <input type="checkbox"/> Volts <input type="checkbox"/> Length of drop pipe <input type="checkbox"/> ft. capacity <input type="checkbox"/> g.p.m. Type: <input type="checkbox"/> Submersible <input type="checkbox"/> Turbine <input type="checkbox"/> Jet <input type="checkbox"/> Reciprocating <input type="checkbox"/> Centrifugal <input type="checkbox"/> Other					
								20. Water well contractor's certification: This well was drilled under my jurisdiction and this report is true to the best of my knowledge and belief. <b>TW WATER WELL SERVICE 142</b> Business name <b>Box 816 Liberal Ks 67901</b> License No. <input type="checkbox"/> Address <b>Liberal</b> Signed <b>[Signature]</b> Date <b>3/20/81</b> Authorized representative					
18. Elevation: Topography: <input type="checkbox"/> Hill <input type="checkbox"/> Slope <input checked="" type="checkbox"/> Upland <input type="checkbox"/> Valley		19. Remarks: <b>16 well drilled in pasture 17. to be completed by different pump company.</b>											

Forward the white, blue and pink copies to the Department of Health and Environment

Form WWC-5