


1 LOCATION OF WATER WELL: County: SEWARD	Fraction S2 1/4 S2 1/4 NE 1/4	Section Number 6	Township Number T 32 S	Range Number R 33W EW
---	----------------------------------	---------------------	---------------------------	--------------------------

Distance and direction from nearest town or city street address of well if located within city?

9 1/2 MILES NORTHWEST ARKALON, KS.

2 WATER WELL OWNER: OXY U.S.A. RR#, St. Address, Box # : BOX 26100 City, State, ZIP Code : OKLAHOMA CITY, OK 731260100	ELLIS C #1 Board of Agriculture, Division of Water Resources Application Number: OXY permitted
--	--

3 LOCATE WELL'S LOCATION WITH AN "X" IN SECTION BOX:

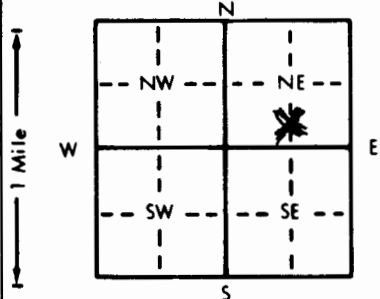

4 DEPTH OF COMPLETED WELL 340 ft. ELEVATION:

Depth(s) Groundwater Encountered 1. 160 ft. 2. ft. 3. ft.

WELL'S STATIC WATER LEVEL 160 ft. below land surface measured on mo/day/yr 9-8-94

Pump test data: Well water was 180 ft. after 1 hours pumping 130 gpm

Est. Yield 130 gpm: Well water was ft. after hours pumping gpm

Bore Hole Diameter 11 in. to 340 ft. and in. to ft.

WELL WATER TO BE USED AS:

1 Domestic	3 Feedlot	6 Oil field water supply	9 Dewatering	12 Other (Specify below)
2 Irrigation	4 Industrial	7 Lawn and garden only	10 Monitoring well	

WAS a chemical/bacteriological sample submitted to Department? Yes No X; If yes, mo/day/yr sample was submitted

Water Well Disinfected? Yes X No

5 TYPE OF BLANK CASING USED:

1 Steel	3 RMP (SR)	6 Asbestos-Cement	9 Other (specify below)
2 PVC	4 ABS	7 Fiberglass	

CASING JOINTS: Glued X Clamped Welded Threaded

Blank casing diameter 6 in. to 340 ft., Dia in. to ft., Dia in. to ft.

Casing height above land surface 24 in., weight 2.902 lbs./ft. Wall thickness or gauge No. 316 SDR 21

TYPE OF SCREEN OR PERFORATION MATERIAL:

1 Steel	3 Stainless steel	5 Fiberglass	8 RMP (SR)	11 Other (specify)
2 Brass	4 Galvanized steel	6 Concrete tile	9 ABS	12 None used (open hole)

SCREEN OR PERFORATION OPENINGS ARE:

1 Continuous slot	3 Mill slot	6 Wire wrapped	9 Drilled holes
2 Louvered shutter	4 Key punched	7 Torch cut	10 Other (specify)

SCREEN-PERFORATED INTERVALS: From 280 ft. to 340 ft., From ft. to ft., From ft. to ft., From ft. to ft.

GRAVEL PACK INTERVALS: From 250 ft. to 340 ft., From ft. to ft., From ft. to ft., From ft. to ft.

6 GROUT MATERIAL: 1 Neat cement 2 Cement grout 3 Bentonite 4 Other HOLE PLUG

Grout Intervals: From 1 ft. to 20 ft., From ft. to ft., From ft. to ft., From ft. to ft.

What is the nearest source of possible contamination:

1 Septic tank	4 Lateral lines	7 Pit privy	10 Livestock pens	14 Abandoned water well
2 Sewer lines	5 Cess pool	8 Sewage lagoon	11 Fuel storage	15 Oil well/Gas well
3 Watertight sewer lines	6 Sewage pit	9 Feedyard	12 Fertilizer storage	16 Other (specify below)

Direction from well? West How many feet? 1000

FROM	TO	LITHOLOGIC LOG	FROM	TO	PLUGGING INTERVALS
0	1	TOP			
1	28	SANDY CLAY			
28	34	CLAY			
34	67	SAND & GRAVEL			
67	93	SANDY CLAY			
93	297	SANDY GRAVEL			
297	325	SANDY CLAY W/SAND STREAKS			
325	340	SAND & BLACK CLAY			

7 CONTRACTOR'S OR LANDOWNER'S CERTIFICATION: This water well was (1) constructed, (2) reconstructed, or (3) plugged under my jurisdiction and was completed on (mo/day/year) 9-8-94 and this record is true to the best of my knowledge and belief. Kansas Water Well Contractor's License No. KWWCL-430. This Water Well Record was completed on (mo/day/yr) 9-8-94 under the business name of HOWARD DRIG.CO.BOX 806 BEAVER, OK 73932 by (signature) Howard Drig

INSTRUCTIONS: Use typewriter or ball point pen. PLEASE PRESS FIRMLY and PRINT clearly. Please fill in blanks, underline or circle the correct answers. Send top three copies to Kansas Department of Health and Environment, Bureau of Water, Topeka, Kansas 66620-0001. Telephone: 913-296-5545. Send one to WATER WELL OWNER and retain one for your records.