

County: Seward Fraction SE-SE-SW Sec. 8 T 32 S R 34 E/W

CORRECTION(S) TO WATER WELL COMPLETION RECORD (WWC-5)

(to rectify lacking or incorrect information)

Owner: Roberts, Tom

Location was listed as:

Section-Township-Range: _____

Fraction ($\frac{1}{4}$ $\frac{1}{4}$ $\frac{1}{4}$): _____

Location changed to:

Other changes: Initial statements: Haskell County

Changed to: Seward County

Comments: _____

Verification method: Seward County Parcel Search, Online map of Address, Aerial Image

initials: _____ date: _____

Submitted by: Kansas Geological Survey, Data Resources Library, 1930 Constant Ave., Lawrence, KS 66047-3726

to: Kansas Dept of Health & Environment, Bureau of Water, 1000 SW Jackson, Suite 420, Topeka, KS 66612-1367.


WATER WELL RECORD Form WWC-5 KSA 82a-1212

1 LOCATION OF WATER WELL: Fraction Section Number Township Number Range Number
 COUNTY: HASKELL SE 1/4 SE 1/4 SW 1/4 8 T 32 S R 34 W

Distance and direction from nearest town or city street address of well if located within city?
 FROM SATANTA - 6W ON 56 - 15 SOUTH & 1/4 MILE EAST

2 WATER WELL OWNER: ROBERTS, TOM
 RR#, St. Address, Box #: 1381 ROAD 16 Board of Agriculture, Division of Water Resources
 City, State, ZIP code: MOSCOW, KS 67952- Application Number:

3 LOCATE WELL'S LOCATION WITH AN "X" IN SECTION BOX:

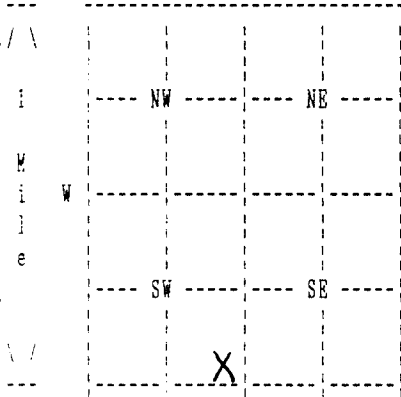

4 DEPTH OF COMPLETED WELL 510 ELEVATION: 0
 Depth(s) Groundwater Encountered 1. 0 ft. 2. 0 ft. 3. 0 ft.

WELL'S STATIC WATER LEVEL 280 ft. below land surface measured on mo/day/yr 12/15/04
 Pump testdata: Well water was 0 ft. after 0 hours pumping 0 gpm
 Estimated Yield 50 gpm: Well water was 0 ft. after 0 hours pumping 0 gpm
 Bore Hole Diameter 10 in. to 510 ft., and in. to 0 ft.
 WELL WATER TO BE USED AS: DOMESTIC

Was a chemical/bacteriological sample submitted to department? No ;
 If yes, mo/day/yr sample was submitted Water well disinfected? Yes

5 TYPE OF BLANK CASING USED: CERTA LOC CASIN CASING JOINTS: CERTA-LOC
 Blank casing diameter 5 in. to 510 ft., Dia in. to 0 ft., Dia in. to 0 ft.
 Casing height above land surface 12 in., weight 200 lbs/ft. Wall thickness or gauge No. 17
 TYPE OF SCREEN OR PERFORATION MATERIAL: PVC
 SCREEN OR PERFORATION OPENINGS ARE: SAW CUT

SCREEN PERFORATED INTERVALS: From 340 ft. to 400 ft., From 0 ft. to 0 ft.
 From 440 ft. to 500 ft., From 0 ft. to 0 ft.
 GRAVEL PACK INTERVALS: From 26 ft. to 510 ft., From 0 ft. to 0 ft.
 From 0 ft. to 0 ft., From 0 ft. to 0 ft.

6 GROUT MATERIAL BENTONITE
 Grout Intervals: From 5 ft. to 26 ft., From 0 ft. to 0 ft., From 0 ft. to 0 ft.
 What is the nearest source of possible contamination: NONE - NEW SITE
 Direction from well? How many feet? 0

FROM	TO	LITHOLOGIC LOG	FROM	TO	PLUGGING INTERVALS
0	20	01 TOPSOIL 05 CLAY			
20	140	32 TAN CLAY 02 FINE SAND 19 LAYERS			
140	400	37 FIN-COAR SAN			
400	420	37 FIN-COAR SAN 05 CLAY			
420	430	26 RED CLAY			
430	510	29 SANDSTONE			

7 CONTRACTOR'S OR LANDOWNER'S CERTIFICATION: This water well was Constructed under my jurisdiction and was completed on (mo/day/year) 12/16/04 and this record is true to the best of my knowledge and belief. Kansas Water Well Contractor's License No. 179 This Water Well Record was completed on (mo/day/yr) 01/04/05 under the business name of JOB'S WELL SERVICE, INC. by (signature) *Quaid Creek*