

**WATER WELL RECORD**

**Form WWC-5**

Division of Water Resources App. No.


25590

<b>1 LOCATION OF WATER WELL:</b> County: Seward	Fraction ¼ SE ¼ NE ¼ NW ¼	Section Number 20	Township No. T 32 S	Range Number R 34 <input type="checkbox"/> E <input checked="" type="checkbox"/> W
--	------------------------------	----------------------	------------------------	---

Street/Rural Address of Well Location; if unknown, distance & direction from nearest town or intersection: If at owner's address, check here .  
5 Miles SW and 9 Miles West of Satanta

**Global Positioning System (GPS) information:**  
Latitude: .....N.37.25448..... (in decimal degrees)  
Longitude: W.101.04079..... (in decimal degrees)  
Elevation: .....  
Datum:  WGS 84,  NAD 83,  NAD 27  
Collection Method:  
 GPS unit (Make/Model: .....)  
 Digital Map/Photo,  Topographic Map,  Land Survey  
Est. Accuracy:  <3 m,  3-5 m,  5-15 m,  >15 m

**2 WATER WELL OWNER:** E Paul Boles Trust  
RR#, Street Address, Box #: PO Box 919  
City, State, ZIP Code : Liberal, Ks 67905

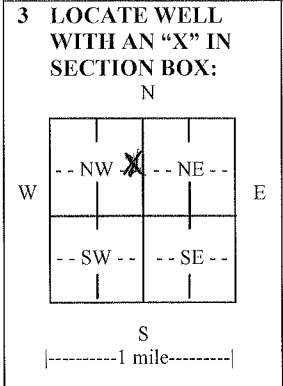

**4 DEPTH OF COMPLETED WELL** 505..... ft.

Depth(s) Groundwater Encountered (1)..... ft. (2)..... ft. (3)..... ft.

WELL'S STATIC WATER LEVEL 310..... ft. below land surface measured on mo/day/yr. 9-1-2011.....

Pump test data: Well water was 340'.....ft. after 2.5..... hours pumping 1003..... gpm

EST. YIELD.....gpm. Well water was.....ft. after..... hours pumping..... gpm

Bore Hole Diameter 24.....in. to 505.....ft., and .....in. to .....ft.

WELL WATER TO BE USED AS:  Public water supply  Geothermal  Injection well  
 Domestic  Feedlot  Oil field water supply  Dewatering  Other (Specify below)  
 Irrigation  Industrial  Domestic-lawn & garden  Monitoring well .....

Was a chemical/bacteriological sample submitted to Department?  Yes  No

If yes, mo/day/yr sample was submitted.....

Water well disinfected?  Yes  No

**5 TYPE OF CASING USED:**  Steel  PVC  Other .....

CASING JOINTS:  Glued  Clamped  Welded  Threaded

Casing diameter .16..... in. to 505..... ft., Diameter ..... in. to ..... ft., Diameter ..... in. to ..... ft.

Casing height above land surface 12..... in., Weight 42.09.....lbs./ft., Wall thickness or gauge No. 250.....

TYPE OF SCREEN OR PERFORATION MATERIAL:  
 Steel  Stainless Steel  PVC  Other (Specify) .....  
 Brass  Galvanized Steel  None used (open hole)

SCREEN OR PERFORATION OPENINGS ARE:  
 Continuous slot  Mill slot  Gauze wrapped  Torch cut  Drilled holes  None (open hole)  
 Louvered shutter  Key punched  Wire wrapped  Saw cut  Other (specify) .....

SCREEN-PERFORATED INTERVALS: From 310..... ft. to 350..... ft., From 350..... ft. to 500..... ft.  
From..... ft. to ..... ft., From..... ft. to ..... ft.

GRAVEL PACK INTERVALS: From 20..... ft. to 505..... ft., From..... ft. to ..... ft.  
From..... ft. to ..... ft., From..... ft. to ..... ft.

**6 GROUT MATERIAL:**  Neat cement  Cement grout  Bentonite  Other .....

Grout Intervals: From 0..... ft. to 20..... ft., From..... ft. to ..... ft., From..... ft. to ..... ft.

What is the nearest source of possible contamination:  
 Septic tank  Lateral lines  Pit privy  Livestock pens  Insecticide storage  Other (specify below)  
 Sewer lines  Cesspool  Sewage lagoon  Fuel storage  Abandoned water well  
 Watertight sewer lines  Seepage pit  Feedyard  Fertilizer storage  Oil well/gas well .....

Direction from well East & South..... Distance from well 30 & 415.....

FROM	TO	LITHOLOGIC LOG	FROM	TO	LITHO. LOG (cont.) or PLUGGING INTERVALS
0	2	Top Soil	425	440	Soapstone & Sandstone
2	41	Brown Sandy Clay	440	474	Sandstone- used some water
41	56	Fine Sand W/ Couple Clay strings	474	500	Sandstone- lost circ, mix brand
56	64	Sand Fine to Med Small gravel	500	520	Red Bed
64	89	Brown Clay w/ couple sand strips			
89	108	Fine Sand w/ couple clay ledges			
108	147	Brown Sandy clay			
147	240	Sand fine to Med, Sm. gravel			
240	364	Sand Fine to med Course			
364	425	Fine sand w/ couple clay stringers			

**7 CONTRACTOR'S OR LANDOWNER'S CERTIFICATION:** This water well was  constructed,  reconstructed, or  plugged under my jurisdiction and was completed on (mo/day/year) ..... and this record is true to the best of my knowledge and belief. Kansas Water Well Contractor's License No. 145..... This Water Well Record was completed on (mo/day/year) 10/31/11..... under the business name of HYDRO RESOURCES..... by (signature) *Barbara J. Kieckhefer*.....

**INSTRUCTIONS:** Use typewriter or ball point pen. PLEASE PRESS FIRMLY and PRINT clearly. Please fill in blanks and check the correct answers. Send three copies (white, blue, pink) to Kansas Department of Health and Environment, Bureau of Water, Geology Section, 1000 SW Jackson St., Suite 420, Topeka, Kansas 66612-1367. Telephone 785-296-5522. Send one copy to WATER WELL OWNER and retain one for your records. Include fee of \$5.00 for each constructed well. Visit us at <http://www.kdheks.gov/waterwell/index.html>.