

CORRECTION TO WATER WELL RECORD (WWC-5)

The following correction(s) was made to the attached WWC-5 log, in order to file the item or to rectify lacking or incorrect information.

Fraction ( 1/4 1/4 1/4) Section-Township-Range changed:

listed as 3 32s 24w

changed to 3-32-34w

Other changes: Initial statements: \_\_\_\_\_

Changed to: \_\_\_\_\_

Comments: \_\_\_\_\_

verification method: Moscow 7.5 ; disc on form.


initials: ES date: 5/4/99

submitted by: Kansas Geological Survey, Data Resources Library, 1930 Constant Ave., Lawrence, KS 66047-3726  
to: Kansas Dept of Health & Environment Bureau of Water Industrial Programs, Bldg 283, Forbes Field, KS 66620

1 LOCATION OF WATER WELL: Fraction **NE 1/4 SE 1/4 NE 1/4** Section Number **3** Township Number **T 32 S** Range Number **R 24 E/W**  
 County: **Seward**

Distance and direction from nearest town or city street address of well if located within city?  
**14 North, 5 West, 1 1/2 North, 1/4 East of Liberal, Kansas**

2 WATER WELL OWNER: **Clinton Stalker**  
 RR#, St. Address, Box #: **Santana** Board of Agriculture, Division of Water Resources  
 City, State, ZIP Code: **Santana, Kansas 67870** Application Number: **----**

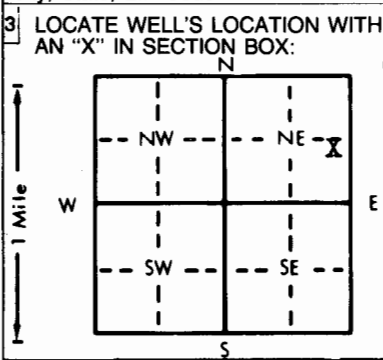

4 DEPTH OF COMPLETED WELL: **246** ft. ELEVATION: **Hill**  
 Depth(s) Groundwater Encountered 1. **104-180** ft. 2. **200-240** ft. 3. \_\_\_\_\_ ft.  
 WELL'S STATIC WATER LEVEL **104** ft. below land surface measured on mo/day/yr **Nov. 19, 1982**  
 Pump test data: Well water was \_\_\_\_\_ ft. after \_\_\_\_\_ hours pumping \_\_\_\_\_ gpm  
 Est. Yield **100** gpm: Well water was \_\_\_\_\_ ft. after \_\_\_\_\_ hours pumping \_\_\_\_\_ gpm  
 Bore Hole Diameter **9 7/8** in. to **246** ft., and \_\_\_\_\_ in. to \_\_\_\_\_ ft.  
 WELL WATER TO BE USED AS:  
 Domestic 3 Feedlot 6 Oil field water supply 9 Dewatering  Other (Specify below) **Stock**  
 2 Irrigation 4 Industrial 7 Lawn and garden only 10 Observation well  
 Was a chemical/bacteriological sample submitted to Department? Yes \_\_\_\_\_ No ; If yes, mo/day/yr sample was submitted  
 Water Well Disinfected? Yes  No

5 TYPE OF BLANK CASING USED:  
 1 Steel  PVC 3 RMP (SR) 4 ABS 5 Wrought iron 6 Asbestos-Cement 7 Fiberglass 8 Concrete tile 9 Other (specify below) CASING JOINTS: Glued  Clamped \_\_\_\_\_  
 Welded \_\_\_\_\_ Threaded \_\_\_\_\_  
 Blank casing diameter **5** in. to **206** ft., Dia \_\_\_\_\_ in. to \_\_\_\_\_ ft., Dia \_\_\_\_\_ in. to \_\_\_\_\_ ft.  
 Casing height above land surface **12** in., weight **3.92** ~~2.8~~ lbs./ft. Wall thickness or gauge No. **XXB** **.375**  
 TYPE OF SCREEN OR PERFORATION MATERIAL:  
 Steel 3 Stainless steel 5 Fiberglass 8 RMP (SR) 10 Asbestos-cement 11 Other (specify) \_\_\_\_\_  
 Brass 4 Galvanized steel 6 Concrete tile 9 ABS 12 None used (open hole)  
 SCREEN OR PERFORATION OPENINGS ARE:  
 Continuous slot 3 Mill slot 5 Gauzed wrapped  Saw cut 11 None (open hole)  
 Louvered shutter 4 Key punched 6 Wire wrapped 9 Drilled holes 10 Other (specify) \_\_\_\_\_  
 SCREEN-PERFORATED INTERVALS: From **206** ft. to **246** ft., From \_\_\_\_\_ ft. to \_\_\_\_\_ ft.  
 GRAVEL PACK INTERVALS: From **14** ft. to **246** ft., From \_\_\_\_\_ ft. to \_\_\_\_\_ ft.

6 GROUT MATERIAL:  Neat cement 2 Cement grout 3 Bentonite 4 Other \_\_\_\_\_  
 Grout Intervals: From **4** ft. to **14** ft., From \_\_\_\_\_ ft. to \_\_\_\_\_ ft., From \_\_\_\_\_ ft. to \_\_\_\_\_ ft.  
 What is the nearest source of possible contamination:  
 1 Septic tank 4 Lateral lines 7 Pit privy 11 Fuel storage 14 Abandoned water well  
 2 Sewer lines 5 Cess pool 8 Sewage lagoon 12 Fertilizer storage  Other (specify below) **Salt Well**  
 3 Watertight sewer lines 6 Seepage pit 9 Feedyard 13 Insecticide storage  
 Direction from well? **Southeast** How many feet? **1400**

FROM	TO	LITHOLOGIC LOG	FROM	TO	LITHOLOGIC LOG
0	1	Topsoil			
1	7	Sandy Clay			
7	75	Med. to Lar. Sand			
75	140	Clay w/Strips of Fine to Med. Sand			
140	180	Fine Sand			
180	200	Clay			
200	240	Med. Sand w/Clay Streaks			
240	265	Yellow Clay			
265	280	Very Fine Sugar Sand			

7 CONTRACTOR'S OR LANDOWNER'S CERTIFICATION: This water well was (1) constructed, (2) reconstructed, or (3) plugged under my jurisdiction and was completed on (mo/day/year) **December 3, 1982** and this record is true to the best of my knowledge and belief. Kansas Water Well Contractor's License No. **252** This Water Well Record was completed on (mo/day/year) **December 9, 1982** under the business name of **Friesen Windmill & Supply Inc.** by (signature) \_\_\_\_\_

INSTRUCTIONS: Use typewriter or ball point pen, **PLEASE PRESS FIRMLY** and **PRINT** clearly. Please fill in blanks, underline or circle the correct answers. Send top three copies to Kansas Department of Health and Environment, Division of Environment, Environmental Geology Section, Topeka, KS 66620. Send one to WATER WELL OWNER and retain one for your records.

OFFICE USE ONLY

T

32

R

24

EW

SEC:

3

1/2

1/4

1/2

1/4

1/2

1/4

1/2

1/4