


1 LOCATION OF WATER WELL: County: Seward	Fraction NW 1/4 NW 1/4 NW 1/4	Section Number 3	Township Number T 32 S	Range Number R 34 EW
---	----------------------------------	---------------------	---------------------------	-------------------------

Distance and direction from nearest town or city street address of well if located within city? Liberal 17 mi. north Jct. 160-83 - 8 mi. west - 2 north - west into.

2 WATER WELL OWNER: Clinton L. Stalker, Jr. SWEETMAN DRLG. / McCoy Petrol.
 RR#, St. Address, Box # : Board of Agriculture, Division of Water Resources
 City, State, ZIP Code : Satanta, Kansas 67870 Application Number: T89-195

3 LOCATE WELL'S LOCATION WITH AN "X" IN SECTION BOX:

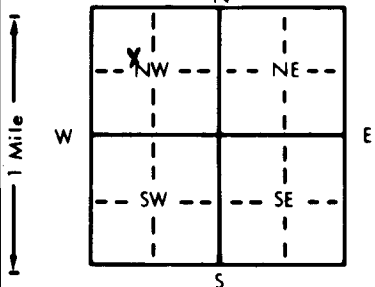

4 DEPTH OF COMPLETED WELL: 240 ft. ELEVATION:ft.
 Depth(s) Groundwater Encountered 1. 109 ft. 2.ft. 3.ft.
 WELL'S STATIC WATER LEVELft. below land surface measured on mo/day/yr 5-3-89
 Pump test data: Well water wasft. after hours pumping gpm
 Est. Yield 100 gpm: Well water wasft. after hours pumping gpm
 Bore Hole Diameter 9 in. toft., andin. toft.
 WELL WATER TO BE USED AS:
 5 Public water supply 8 Air conditioning 11 Injection well
 1 Domestic 3 Feedlot 6 Oil field water supply 9 Dewatering 12 Other (Specify below)
 2 Irrigation 4 Industrial 7 Lawn and garden only 10 Monitoring well
 Was a chemical/bacteriological sample submitted to Department? Yes.....No X.....; If yes, mo/day/yr sample was submitted
 Water Well Disinfected? Yes X No

5 TYPE OF BLANK CASING USED:
 1 Steel 3 RMP (SR) 5 Wrought iron 8 Concrete tile CASING JOINTS: Glued X Clamped
 2 PVC 4 ABS 6 Asbestos-Cement 9 Other (specify below) Welded
 7 Fiberglass Threaded
 Blank casing diameter 5.563 in. to 240 ft., Diain. toft., Diain. toft.
 Casing height above land surface 30 in., weight 2.93 lbs./ft. Wall thickness or gauge No. 265
 TYPE OF SCREEN OR PERFORATION MATERIAL:
 1 Steel 3 Stainless steel 5 Fiberglass 7 PVC 10 Asbestos-cement
 2 Brass 4 Galvanized steel 6 Concrete tile 8 RMP (SR) 11 Other (specify)
 12 None used (open hole)
 SCREEN OR PERFORATION OPENINGS ARE:
 1 Continuous slot 3 Mill slot 5 Gauzed wrapped 8 Saw cut 11 None (open hole)
 2 Louvered shutter 4 Key punched 6 Wire wrapped 9 Drilled holes
 7 Torch cut 10 Other (specify)
 SCREEN-PERFORATED INTERVALS: From 120 ft. to 160 ft., From 180 ft. to 240 ft.
 Fromft. toft., Fromft. toft.
 GRAVEL PACK INTERVALS: From 22 ft. to 90 ft., From 100 ft. to 240 ft.
 Fromft. toft., Fromft. toft.

6 GROUT MATERIAL: 1 Neat cement 2 Cement grout 3 Bentonite 4 Other
 Grout intervals: From 0 ft. to 2 ft., From 2 ft. to 22 ft., From 90 ft. to 100 ft.
 What is the nearest source of possible contamination:
 1 Septic tank 4 Lateral lines 7 Pit privy 10 Livestock pens 14 Abandoned water well
 2 Sewer lines 5 Cess pool 8 Sewage lagoon 11 Fuel storage 15 Oil well/Gas well
 3 Watertight sewer lines 6 Seepage pit 9 Feedyard 12 Fertilizer storage 16 Other (specify below)
 13 Insecticide storage
 Direction from well? East How many feet? 150

FROM	TO	LITHOLOGIC LOG	FROM	TO	PLUGGING INTERVALS
0	2	Surface			
2	16	Clay			
16	41	Med. to large sand			
41	49	Clay			
49	81	Med. to large sand			
81	96	5% gravel-90% sandy clay-5% sandstone			
96	102	Clay			
102	164	5% clay-95% med. to large sand			
164	180	50% med to large sand-50% sandy clay			
180	204	Med. to large sand			
204	218	50% Clay - 50% med. to large sand			
218	240	5% clay-95% med. to large sand			

7 CONTRACTOR'S OR LANDOWNER'S CERTIFICATION: This water well was (1) constructed, (2) reconstructed, or (3) plugged under my jurisdiction and was completed on (mo/day/year) May 3, 1989 and this record is true to the best of my knowledge and belief. Kansas Water Well Contractor's License No. 118 This Water Well Record was completed on (mo/day/yr) 5-10-89 under the business name of Carlile Water Well Service, Inc. by (signature)

OFFICE USE ONLY T R EW SEC 1/4 1/4 1/4