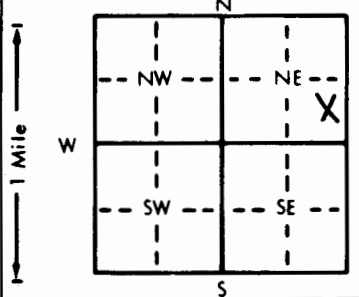


1 LOCATION OF WATER WELL: Fraction Section Number Township Number Range Number  
 County: Seward C/SE 1/4 NE 1/4 SE 1/4 34 T 32 S R 34 EW

Distance and direction from nearest town or city street address of well if located within city?

From Liberal: 12N, 4W, 1/2N into--

2 WATER WELL OWNER: OXY USA #3 Hitch L  
 RR#, St. Address, Box #: P. O. Box 26100 Board of Agriculture, Division of Water Resources  
 City, State, ZIP Code: Oklahoma City, OK 73126-0100 Application Number: Oxy Permitted

3 LOCATE WELL'S LOCATION WITH AN "X" IN SECTION BOX:  4 DEPTH OF COMPLETED WELL: 280 ft. ELEVATION:  
 Depth(s) Groundwater Encountered 1. 220 ft. 2. ft. 3. ft.  
 WELL'S STATIC WATER LEVEL: 220 ft. below land surface measured on mo/day/yr 10/09/92.  
 Pump test data: Well water was 220 ft. after 1 hours pumping 100 gpm  
 Est. Yield 100 gpm: Well water was ft. after hours pumping gpm  
 Bore Hole Diameter 11 in. to 280 ft., and in. to ft.  
 WELL WATER TO BE USED AS: 5 Public water supply 8 Air conditioning 11 Injection well  
 1 Domestic 3 Feedlot 6 Oil field water supply 9 Dewatering 12 Other (Specify below)  
 2 Irrigation 4 Industrial 7 Lawn and garden only 10 Monitoring well  
 Was a chemical/bacteriological sample submitted to Department? Yes No X; If yes, mo/day/yr sample was submitted  
 Water Well Disinfected? Yes X No

5 TYPE OF BLANK CASING USED: 5 Wrought iron 8 Concrete tile CASING JOINTS: Glued X Clamped  
 1 Steel 3 RMP (SR) 6 Asbestos-Cement 9 Other (specify below) Welded  
 2 PVC 4 ABS 7 Fiberglass Threaded  
 Blank casing diameter 6 in. to 280 ft., Dia. in. to ft., Dia. in. to ft.  
 Casing height above land surface 24 in., weight 2.902 lbs./ft. Wall thickness or gauge No. 280 SDR21  
 TYPE OF SCREEN OR PERFORATION MATERIAL: 7 PVC 10 Asbestos-cement  
 1 Steel 3 Stainless steel 5 Fiberglass 8 RMP (SR) 11 Other (specify)  
 2 Brass 4 Galvanized steel 6 Concrete tile 9 ABS 12 None used (open hole)  
 SCREEN OR PERFORATION OPENINGS ARE: 5 Gauzed wrapped 8 Saw cut 11 None (open hole)  
 1 Continuous slot 3 Mill slot 6 Wire wrapped 9 Drilled holes  
 2 Louvered shutter 4 Key punched 7 Torch cut 10 Other (specify)  
 SCREEN-PERFORATED INTERVALS: From 200 ft. to 280 ft., From ft. to ft.  
 From ft. to ft., From ft. to ft.  
 GRAVEL PACK INTERVALS: From 80 ft. to 280 ft., From ft. to ft.  
 From ft. to ft., From ft. to ft.

6 GROUT MATERIAL: 1 Neat cement 2 Cement grout 3 Bentonite 4 Other Hole Plug  
 Grout Intervals: From 1 ft. to 20 ft., From ft. to ft., From ft. to ft.  
 What is the nearest source of possible contamination:  
 1 Septic tank 4 Lateral lines 7 Pit privy 10 Livestock pens 14 Abandoned water well  
 2 Sewer lines 5 Cess pool 8 Sewage lagoon 11 Fuel storage 15 Oil well/Gas well  
 3 Watertight sewer lines 6 Seepage pit 9 Feedyard 12 Fertilizer storage 16 Other (specify below)  
 13 Insecticide storage  
 Direction from well? Northeast How many feet? 1000'

FROM	TO	LITHOLOGIC LOG	FROM	TO	PLUGGING INTERVALS
0	2	Surface Soil			
2	7	Hard Sand			
7	36	Clay			
36	64	Sand			
64	80	Clay			
80	128	Sandy Clay			
128	144	Sand			
144	165	Sandy Clay			
165	180	Coarse Sand			
180	263	Sand & Gravel			
263	280	Brown Clay			

7 CONTRACTOR'S OR LANDOWNER'S CERTIFICATION: This water well was (1) constructed, (2) reconstructed, or (3) plugged under my jurisdiction and was completed on (mo/day/year) 10/09/92 and this record is true to the best of my knowledge and belief. Kansas Water Well Contractor's License No. KWWCL-430. This Water Well Record was completed on (mo/day/yr) 10/09/92 under the business name of Howard Drlg. Co. Box 806 Beaver, OK 73932 by (signature) *Alvin Howard*

INSTRUCTIONS: Use typewriter or ball point pen. PLEASE PRESS FIRMLY and PRINT clearly. Please fill in blanks, underline or circle the correct answers. Send top three copies to Kansas Department of Health and Environment, Bureau of Water, Topeka, Kansas 66620-0001. Telephone: 913-296-5545. Send one to WATER WELL OWNER and retain one for your records.