


1 LOCATION OF WATER WELL: Fraction Section Number Township Number Range Number
 COUNTY: STEVENS NE 1/4 NE 1/4 NW 1/4 13 T 32 S R 35 W

Distance and direction from nearest town or city street address of well if located within city?
 FROM MOSCOW, KS - 3 1/2 ON BLACK TOP - 7 E. ON BLACK TOP

2 WATER WELL OWNER: KANCO PROPERTIES Board of Agriculture, Division of Water Resources
 RR#, St. Address, Box #: P.O. BOX 507 Application Number:
 City, State, ZIP code: LA VETA, CO 81055-

3 LOCATE WELL'S LOCATION WITH AN "X" IN SECTION BOX:

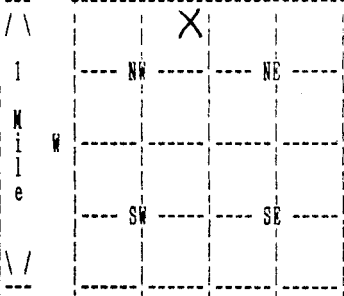

4 DEPTH OF COMPLETED WELL 219 ELEVATION: 0
 Depth(s) Groundwater Encountered 1. 0 ft. 2. 0 ft. 3. 0 ft.

WELL'S STATIC WATER LEVEL 0 ft. below land surface measured on no/day/yr
 Pump test data: Well water was 0 ft. after 0 hours pumping 0 gpm

Estimated Yield 0 gpm; Well water was 0 ft. after 0 hours pumping 0 gpm

Bore Hole Diameter in. to 0 ft., and in. to 0 ft.

WELL WATER WAS: DOMESTIC

Was a chemical/bacteriological sample submitted to department? No;
 If yes, no/day/yr sample was submitted Water well disinfected? Yes

5 TYPE OF BLANK CASING USED: STEEL CASING JOINTS:
 Blank casing diameter 8 in. to 219 ft., Dia in. to 0 ft., Dia in. to 0 ft.
 Casing height above land surface 0 in., weight 0 lbs/ft. Wall thickness or gauge No.
 TYPE OF SCREEN OR PERFORATION MATERIAL:
 SCREEN OR PERFORATION OPENINGS ARE:

SCREEN PERFORATED INTERVALS: From 0 ft. to 0 ft., From 0 ft. to 0 ft.
 GRAVEL PACK INTERVALS: From 0 ft. to 0 ft., From 0 ft. to 0 ft.
 From 0 ft. to 0 ft., From 0 ft. to 0 ft.

6 GROUT MATERIAL BENTONITE
 Grout intervals: From 0 ft. to 0 ft., From 0 ft. to 0 ft., From 0 ft. to 0 ft.
 What is the nearest source of possible contamination: NONE How many feet? 0
 Direction from well?

FROM	TO	LITHOLOGIC LOG	FROM	TO	PLUGGING INTERVALS
			0	20	BENTONITE GROUT
			20	180	FILL SAND
			180	200	BENTONITE GROUT
			200	219	FILL SAND
			0	0	
			0	0	
			0	0	
			0	0	
			0	0	
			0	0	

7 CONTRACTOR'S OR LANDOWNER'S CERTIFICATION: This water well was plugged under my jurisdiction and was completed on (no/day/year) 10/06/95 and this record is true to the best of my knowledge and belief. Kansas Water Well Contractor's License No. 179 This Water Well Record was completed on (no/day/yr) 10/12/95 under the business name of JOE'S WELL SERVICE, INC. by (signature) *Justin Creek*