


1 LOCATION OF WATER WELL: County: STEVENS Fraction: SW 1/4 SW 1/4 SE 1/4 Section Number: 9 Township Number: T 32 S Range Number: R 35 EW

Distance and direction from nearest town or city street address of well if located within city?
SOUTH OF MOSCOW TO V THEN 4 1/2 MILES EAST.

2 WATER WELL OWNER: DON SNYDER
RR#, St. Address, Box #: ROUTE NO. 1 Board of Agriculture, Division of Water Resources
City, State, ZIP Code: MOSCOW, KS 67592 Application Number: 41,750

3 LOCATE WELL'S LOCATION WITH AN "X" IN SECTION BOX:

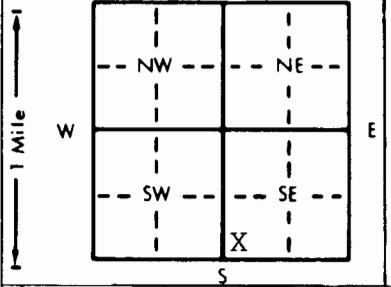

4 DEPTH OF COMPLETED WELL: 535 ft. ELEVATION:

Depth(s) Groundwater Encountered 1. ft. 2. ft. 3. ft.
WELL'S STATIC WATER LEVEL . . . 217 . . . ft. below land surface measured on mo/day/yr . . . 6/18/96 . . .
Pump test data: Well water was ft. after hours pumping gpm
Est. Yield gpm: Well water was ft. after hours pumping gpm
Bore Hole Diameter . . . 26 . . . in. to . . . 535 . . . ft., and in. to ft.
WELL WATER TO BE USED AS: 5 Public water supply 8 Air conditioning 11 Injection well
1 Domestic 3 Feedlot 6 Oil field water supply 9 Dewatering 12 Other (Specify below)
 Irrigation 4 Industrial 7 Lawn and garden only 10 Monitoring well
Was a chemical/bacteriological sample submitted to Department? Yes No If yes, mo/day/yr sample was submitted
Water Well Disinfected? Yes No

5 TYPE OF BLANK CASING USED: Steel 3 RMP (SR) 5 Wrought iron 8 Concrete tile CASING JOINTS: Glued Clamped
2 PVC 4 ABS 6 Asbestos-Cement 9 Other (specify below) Welded
7 Fiberglass Threaded

Blank casing diameter . . . 16 . . . in. to . . . 535 . . . ft., Dia in. to ft., Dia in. to ft.
Casing height above land surface . . . 12 . . . in., weight . . . 42.5 . . . lbs./ft. Wall thickness or gauge No. . . 250

TYPE OF SCREEN OR PERFORATION MATERIAL: Steel 3 Stainless steel 5 Fiberglass 8 RMP (SR) 10 Asbestos-cement
2 Brass 4 Galvanized steel 6 Concrete tile 9 ABS 11 Other (specify)
12 None used (open hole)

SCREEN OR PERFORATION OPENINGS ARE: Mill slot 5 Gauzed wrapped 8 Saw cut 11 None (open hole)
1 Continuous slot 6 Wire wrapped 9 Drilled holes
2 Louvered shutter 4 Key punched 7 Torch cut 10 Other (specify)

SCREEN-PERFORATED INTERVALS: From PERF. 280 . . . ft. to 300 . . . ft., From PERF. 330 . . . ft. to 350 . . . ft.
From PERF. 390 . . . ft. to 420 . . . ft., From PERF. 440 . . . ft. to 472 . . . ft.
GRAVEL PACK INTERVALS: From . . . 20 . . . ft. to 535 . . . ft., From PERF. 492 . . . ft. to 535 . . . ft.
From ft. to ft., From ft. to ft.

6 GROUT MATERIAL: Neat cement 2 Cement grout 3 Bentonite 4 Other
Grout Intervals: From . . . 0 . . . ft. to 20 . . . ft., From ft. to ft., From ft. to ft.

What is the nearest source of possible contamination:
1 Septic tank 4 Lateral lines 7 Pit privy 10 Livestock pens 14 Abandoned water well
2 Sewer lines 5 Cess pool 8 Sewage lagoon 11 Fuel storage 15 Oil well/Gas well
3 Watertight sewer lines 6 Seepage pit 9 Feedyard 12 Fertilizer storage Other (specify below)
CROPLAND—NOTHING
IMMEDIATE VICINITY

DIRECTION FROM WELL?		LITHOLOGIC LOG		PLUGGING INTERVALS	
FROM	TO	FROM	TO	FROM	TO
0	240				SCREEN SET @ 350-390
240	340				420-440
340	400				472-492
400	480				
480	500				
500	527				
527	540				

7 CONTRACTOR'S OR LANDOWNER'S CERTIFICATION: This water well was constructed, (2) reconstructed, or (3) plugged under my jurisdiction and was completed on (mo/day/year) . . . 6/18/96 . . . and this record is true to the best of my knowledge and belief. Kansas Water Well Contractor's License No. . . . 225 . . . This Water Well Record was completed on (mo/day/yr) . . . 6/19/96 . . . under the business name of KTM DRILLING, INC. by (signature) *[Signature]*