


WATER WELL RECORD Form WWC-5 KSA 82a-1212

1 LOCATION OF WATER WELL: Fraction SW 1/4 SE 1/4 SW 1/4 Section Number 20 Township Number T 32 S Range Number R 35 EW
 County: STEVENS

Distance and direction from nearest town or city street address of well if located within city?
 2 MILES WEST, 5 MILES NORTH & 1/2 MILE WEST FROM WOODS.

2 WATER WELL OWNER: RICK HAMLIN
 RR#, St. Address, Box #: ROUTE 1, BOX 4 Board of Agriculture, Division of Water Resources
 City, State, ZIP Code: HUGOTON, KS 67951 Application Number: 42,463

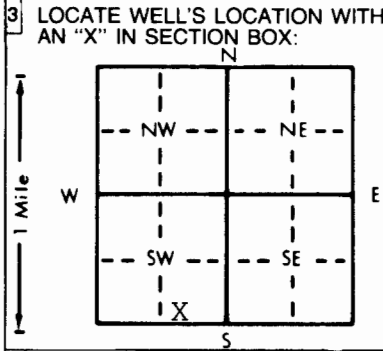

4 DEPTH OF COMPLETED WELL: 561 ft. ELEVATION:
 Depth(s) Groundwater Encountered 1. ft. 2. ft. 3. ft.
 WELL'S STATIC WATER LEVEL . . . 210 ft. below land surface measured on mo/day/yr 3/13/97
 Pump test data: Well water was ft. after hours pumping gpm
 Est. Yield gpm: Well water was ft. after hours pumping gpm
 Bore Hole Diameter . . . 26 in. to . . . 561 ft., and in. to ft.
 WELL WATER TO BE USED AS: 5 Public water supply 8 Air conditioning 11 Injection well
 1 Domestic 3 Feedlot 6 Oil field water supply 9 Dewatering 12 Other (Specify below)
 ② Irrigation 4 Industrial 7 Lawn and garden only 10 Monitoring well
 Was a chemical/bacteriological sample submitted to Department? Yes No . . . X; If yes, mo/day/yr sample was submitted
 Water Well Disinfected? Yes No

5 TYPE OF BLANK CASING USED: 5 Wrought iron 8 Concrete tile CASING JOINTS: Glued Clamped
 ① Steel 3 RMP (SR) 6 Asbestos-Cement 9 Other (specify below) Welded X
 2 PVC 4 ABS 7 Fiberglass Threaded
 Blank casing diameter 16 in. to . . . 561 ft., Dia in. to ft., Dia in. to ft.
 Casing height above land surface 12 in., weight 42.5 lbs./ft. Wall thickness or gauge No. . . . 250
 TYPE OF SCREEN OR PERFORATION MATERIAL: 7 PVC 10 Asbestos-cement
 ① Steel 3 Stainless steel 5 Fiberglass 8 RMP (SR) 11 Other (specify)
 2 Brass 4 Galvanized steel 6 Concrete tile 9 ABS 12 None used (open hole)
 SCREEN OR PERFORATION OPENINGS ARE: 5 Gauzed wrapped 8 Saw cut 11 None (open hole)
 1 Continuous slot ③ Mill slot 6 Wire wrapped 9 Drilled holes
 2 Louvered shutter 4 Key punched 7 Torch cut 10 Other (specify)
 SCREEN-PERFORATED INTERVALS: From PERF. 320 ft. to . . . 480 ft., From SCREEN 480 ft. to . . . 560 ft.
 From ft. to ft., From ft. to ft.
 GRAVEL PACK INTERVALS: From 20 ft. to . . . 561 ft., From ft. to ft.
 From ft. to ft., From ft. to ft.

6 GROUT MATERIAL: ④ Neat cement 2 Cement grout 3 Bentonite 4 Other
 Grout Intervals: From . . . 0 ft. to . . . 20 ft., From ft. to ft., From ft. to ft.
 What is the nearest source of possible contamination: 10 Livestock pens 14 Abandoned water well
 1 Septic tank 4 Lateral lines 7 Pit privy 11 Fuel storage 15 Oil well/Gas well
 2 Sewer lines 5 Cess pool 8 Sewage lagoon 12 Fertilizer storage ⑬ Other (specify below)
 3 Watertight sewer lines 6 Seepage pit 9 Feedyard 13 Insecticide storage CROPLAND--NOTHING
 IMMEDIATE VICINITY

Direction from well? How many feet?

FROM	TO	LITHOLOGIC LOG	FROM	TO	PLUGGING INTERVALS
0	200	SURFACE, CLAY & SAND			
200	240	MED. TO COARSE SAND			
240	300	BROWN CLAY W/SAND			
300	559	FINE TO MED. COARSE SAND			
559	580	BROWN & BLUE CLAY			

7 CONTRACTOR'S OR LANDOWNER'S CERTIFICATION: This water well was ① constructed, (2) reconstructed, or (3) plugged under my jurisdiction and was completed on (mo/day/year) . . . 3/12/97 and this record is true to the best of my knowledge and belief. Kansas Water Well Contractor's License No. . . . 225 This Water Well Record was completed on (mo/day/yr) . . . 5/13/97 under the business name of KTM DRILLING, INC. by (signature) *Rick Hamlin*

INSTRUCTIONS: Use typewriter or ball point pen. PLEASE PRESS FIRMLY and PRINT clearly. Please fill in blanks, underline or circle the correct answers. Send three copies to Kansas Department of Health and Environment, Bureau of Water, Topeka, Kansas 66620-0001. Telephone: 913-296-5545. Send one to WATER WELL OWNER and retain one for your records.