


1 LOCATION OF WATER WELL: Fraction SE 1/4 SW 1/4 SE 1/4 Section Number 32 Township Number T 32 S Range Number R 35 ~~EW~~

Distance and direction from nearest town or city street address of well if located within city?
 2 MILES WEST, 3 MILES NORTH & 1/2 MILE WEST FROM WOODS.

2 WATER WELL OWNER: JACK HAMLIN
 RR#, St. Address, Box #: ROUTE 1, BOX 58 Board of Agriculture, Division of Water Resources
 City, State, ZIP Code: MOSCOW, KS 67952 Application Number: 42,467

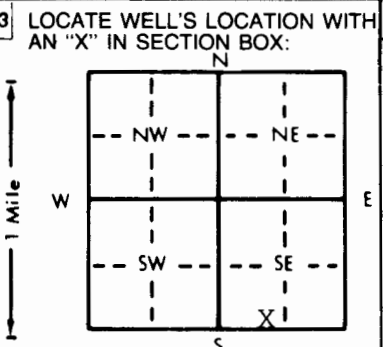

4 DEPTH OF COMPLETED WELL: 542 ft. ELEVATION:
 Depth(s) Groundwater Encountered 1. ft. 2. ft. 3. ft.
 WELL'S STATIC WATER LEVEL 172 ft. below land surface measured on mo/day/yr 3/5/97
 Pump test data: Well water was ft. after hours pumping gpm
 Est. Yield gpm: Well water was ft. after hours pumping gpm
 Bore Hole Diameter . . 26 in. to . . 542 ft., and in. to ft.
 WELL WATER TO BE USED AS: 5 Public water supply 8 Air conditioning 11 Injection well
 1 Domestic 3 Feedlot 6 Oil field water supply 9 Dewatering 12 Other (Specify below)
 ② Irrigation 4 Industrial 7 Lawn and garden only 10 Monitoring well
 Was a chemical/bacteriological sample submitted to Department? Yes No X; If yes, mo/day/yr sample was submitted
 Water Well Disinfected? Yes No

5 TYPE OF BLANK CASING USED: 5 Wrought iron 8 Concrete tile CASING JOINTS: Glued Clamped
 ① Steel 3 RMP (SR) 6 Asbestos-Cement 9 Other (specify below) Welded X
 2 PVC 4 ABS 7 Fiberglass Threaded
 Blank casing diameter . . 16 in. to . . 542 ft., Dia in. to ft., Dia in. to ft.
 Casing height above land surface . . 12 in., weight . . 42.5 lbs./ft. Wall thickness or gauge No. . . 250
 TYPE OF SCREEN OR PERFORATION MATERIAL: 7 PVC 10 Asbestos-cement
 ③ Steel 3 Stainless steel 5 Fiberglass 8 RMP (SR) 11 Other (specify)
 2 Brass 4 Galvanized steel 6 Concrete tile 9 ABS 12 None used (open hole)
 SCREEN OR PERFORATION OPENINGS ARE: 5 Gauzed wrapped 8 Saw cut 11 None (open hole)
 1 Continuous slot ③ Mill slot 6 Wire wrapped 9 Drilled holes
 2 Louvered shutter 4 Key punched 7 Torch cut 10 Other (specify)
 SCREEN-PERFORATED INTERVALS: From PERF. 242 ft. to . . 482 ft., From SC REEN 482 ft. to . . 542 ft.
 From ft. to ft., From ft. to ft.
 GRAVEL PACK INTERVALS: From 20 ft. to . . 542 ft., From ft. to ft.
 From ft. to ft., From ft. to ft.

6 GROUT MATERIAL: ① Neat cement 2 Cement grout 3 Bentonite 4 Other
 Grout Intervals: From . . 0 ft. to . . 20 ft., From ft. to ft., From ft. to ft.
 What is the nearest source of possible contamination:
 1 Septic tank 4 Lateral lines 7 Pit privy 10 Livestock pens 14 Abandoned water well
 2 Sewer lines 5 Cess pool 8 Sewage lagoon 11 Fuel storage 15 Oil well/Gas well
 3 Watertight sewer lines 6 Seepage pit 9 Feedyard 12 Fertilizer storage ①⑥ Other (specify below)
 CROPLAND-NOTHING IMMEDIATE VICINITY
 Direction from well? How many feet?

FROM	TO	LITHOLOGIC LOG	FROM	TO	PLUGGING INTERVALS
0	200	SURFACE, SAND & CLAY			
200	240	BROWN CLAY W/MED. COARSE SAND			
240	280	FINE TO MED. SAND			
280	340	FINE TO MED. COARSE SAND			
340	380	FINE TO MED. SAND			
380	460	FINE TO MED. COARSE SAND			
460	500	FINE TO MED. SAND			
500	558	FINE TO MED. COARSE SAND			
558	580	RED CLAY			

7 CONTRACTOR'S OR LANDOWNER'S CERTIFICATION: This water well was ① constructed, (2) reconstructed, or (3) plugged under my jurisdiction and was completed on (mo/day/year) 3/5/97 and this record is true to the best of my knowledge and belief. Kansas Water Well Contractor's License No. 225 This Water Well Record was completed on (mo/day/yr) 5/13/97 under the business name of KTM DRILLING, INC. by (signature) *Ronald White*

OFFICE USE ONLY T R EWM SEC. 1/4 1/4 1/4