


1 LOCATION OF WATER WELL: County: **Stevens** Fraction: **SE 1/4 NW 1/4 NW 1/4** Section Number: **10** Township Number: **T 32 S** Range Number: **R 35W EW**
 Distance and direction from nearest town or city street address of well if located within city? **Woods, Kansas - 8 miles North - 3/4 miles West - South into location.**

2 WATER WELL OWNER: **Donald Snyder** **Mobil Oil Corp./Unit 19**
 RR#, St. Address, Box #: **Board of Agriculture, Division of Water Resources**
 City, State, ZIP Code: **Moscow, Kansas** Application Number: **T 88-489**

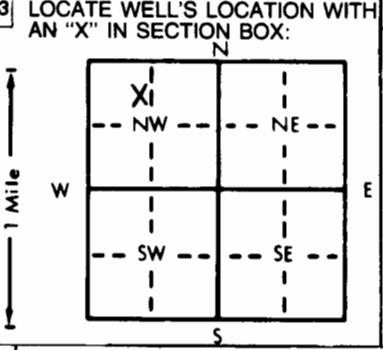

4 DEPTH OF COMPLETED WELL: **480'** ft. ELEVATION: ft.
 Depth(s) Groundwater Encountered 1. ft. 2. ft. 3. ft.
 WELL'S STATIC WATER LEVEL: **216'** ft. below land surface measured on **mo/day/yr** **10/05/88**
 Pump test data: Well water was **238'** ft. after **1** hours pumping **100** gpm
 Est. Yield **100** gpm: Well water was ft. after hours pumping gpm
 Bore Hole Diameter: **11"** in. to **480'** ft., and in. to ft.
 WELL WATER TO BE USED AS:
 5 Public water supply 8 Air conditioning 11 Injection well
 1 Domestic 3 Feedlot **6 Oil field water supply** 9 Dewatering 12 Other (Specify below)
 2 Irrigation 4 Industrial 7 Lawn and garden only 10 Observation well
 Was a chemical/bacteriological sample submitted to Department? Yes.....No **X**.....; If yes, mo/day/yr sample was submitted
 Water Well Disinfected? Yes **X** No

5 TYPE OF BLANK CASING USED:
 1 Steel 3 RMP (SR) 5 Wrought iron 8 Concrete tile CASING JOINTS: Glued Clamped
2 PVC 4 ABS 6 Asbestos-Cement 9 Other (specify below) Welded
 7 Fiberglass Threaded
 Blank casing diameter **6.625** in. to **300'** ft., Dia in. to ft., Dia in. to ft.
 Casing height above land surface **-48"** in., weight lbs./ft. Wall thickness or gauge No.
 TYPE OF SCREEN OR PERFORATION MATERIAL:
 1 Steel 3 Stainless steel 5 Fiberglass **7 PVC** 10 Asbestos-cement
 2 Brass 4 Galvanized steel 6 Concrete tile 9 ABS 11 Other (specify)
 12 None used (open hole)
 SCREEN OR PERFORATION OPENINGS ARE:
 5 Gauzed wrapped **8 Saw cut** 11 None (open hole)
 1 Continuous slot 3 Mill slot 6 Wire wrapped 9 Drilled holes
 2 Louvered shutter 4 Key punched 7 Torch cut 10 Other (specify)
 SCREEN-PERFORATED INTERVALS: From **240'** ft. to **320'** ft., From **360'** ft. to **420'** ft.
 From **440'** ft. to **480'** ft., From ft. to ft.
 GRAVEL PACK INTERVALS: From **27'** ft. to **210'** ft., From **220'** ft. to **480'** ft.
 From ft. to ft., From ft. to ft.

6 GROUT MATERIAL: **1 Neat cement** 2 Cement grout **3 Bentonite** 4 Other
 Grout intervals: From **5** ft. to **7** ft., From **7** ft. to **27** ft., From **210** ft. to **220** ft.
 What is the nearest source of possible contamination:
 1 Septic tank 4 Lateral lines 7 Pit privy 10 Livestock pens 14 ~~Abandoned water well~~
 2 Sewer lines 5 Cess pool 8 Sewage lagoon 11 Fuel storage **15 Oil well/Gas well**
 3 Watertight sewer lines 6 Seepage pit 9 Feedyard 12 Fertilizer storage 16 Other (specify below)
 13 Insecticide storage
 Direction from well? **Southwest** How many feet? **160'**

FROM	TO	LITHOLOGIC LOG	FROM	TO	LITHOLOGIC LOG
0	5	backfill .98 cu. ft of backfill			
5	7	neet cement .39 cu. ft of neet cement			
7	27	bentonite grout 3.93 cu. ft of bentonite grout			
27	210	chlorinated gravel 35.92 cu. ft of chlorinated gravel			
210	220	bentonite grout 1.96 cu. ft of bentonite grout			
220	480	chlorinated gravel 51.04 cu. ft of chlorinated gravel			

7 CONTRACTOR'S OR LANDOWNER'S CERTIFICATION: This water well was (1) constructed, (2) reconstructed, or **(3) plugged under my jurisdiction** and was completed on (mo/day/year) **12/28/88** and this record is true to the best of my knowledge and belief. Kansas Water Well Contractor's License No. **118** This Water Well Record was completed on (mo/day/yr) **12/29/88** under the business name of **Carlile Water Well Service, Inc.** by (signature) *[Signature]*