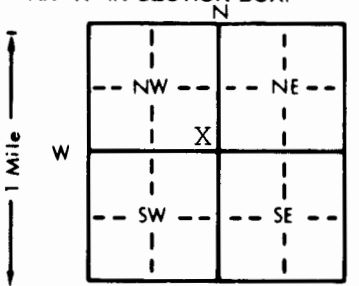


1 LOCATION OF WATER WELL: County: **STEVENS** Fraction: **SE 1/4 SE 1/4 NW 1/4** Section Number: **10** Township Number: **T 32 S** Range Number: **R 35 E/W**

Distance and direction from nearest town or city street address of well if located within city?  
**FOUR MILES SOUTH, FIVE AND ONE-HALF MILES EAST AND ONE-HALF MILE NORTH OF MOSCOW.**

2 WATER WELL OWNER: **DON SNYDER**  
 RR#, St. Address, Box #: **RT. 1** Board of Agriculture, Division of Water Resources  
 City, State, ZIP Code: **MOSCOW, KS 67952** Application Number: **21083**

3 LOCATE WELL'S LOCATION WITH AN "X" IN SECTION BOX:  

 4 DEPTH OF COMPLETED WELL: **522** ft. ELEVATION:  
 Depth(s) Groundwater Encountered 1. .... ft. 2. .... ft. 3. .... ft.  
 WELL'S STATIC WATER LEVEL ..... ft. below land surface measured on mo/day/yr  
 Pump test data: Well water was ..... ft. after ..... hours pumping ..... gpm  
 Est. Yield ..... gpm: Well water was ..... ft. after ..... hours pumping ..... gpm  
 Bore Hole Diameter: **.26** in. to **522** ft., and ..... in. to ..... ft.  
 WELL WATER TO BE USED AS: 5 Public water supply 8 Air conditioning 11 Injection well  
 1 Domestic 3 Feedlot 6 Oil field water supply 9 Dewatering 12 Other (Specify below)  
2 Irrigation 4 Industrial 7 Lawn and garden only 10 Monitoring well  
 Was a chemical/bacteriological sample submitted to Department? Yes ..... No  If yes, mo/day/yr sample was submitted  
 Water Well Disinfected? Yes No

5 TYPE OF BLANK CASING USED:  
 1 Steel 3 RMP (SR) 5 Wrought iron 8 Concrete tile CASING JOINTS: Glued ..... Clamped .....  
 2 PVC 4 ABS 6 Asbestos-Cement 9 Other (specify below) Welded   
 7 Fiberglass Threaded .....  
 Blank casing diameter **16** in. to **522** ft. Dia ..... in. to ..... ft. Dia ..... in. to ..... ft.  
 Casing height above land surface **12** in. weight **42.5** lbs./ft. Wall thickness or gauge No. **250**  
 TYPE OF SCREEN OR PERFORATION MATERIAL:  
 1 Steel 3 Stainless steel 5 Fiberglass 7 PVC 10 Asbestos-cement  
 2 Brass 4 Galvanized steel 6 Concrete tile 8 RMP (SR) 11 Other (specify) .....  
 12 None used (open hole)  
 SCREEN OR PERFORATION OPENINGS ARE:  
 1 Continuous slot 3 Mill slot 5 Gauzed wrapped 8 Saw cut 11 None (open hole)  
 2 Louvered shutter 4 Key punched 6 Wire wrapped 9 Drilled holes  
 7 Torch cut 10 Other (specify) .....  
 SCREEN-PERFORATED INTERVALS: From **PERF. 350** ft. to **410** ft., From **SCREEN 330** ft. to **350** ft.  
 From **PERF. 450** ft. to **500** ft., From **SCREEN 410** ft. to **450** ft.  
 GRAVEL PACK INTERVALS: From **20** ft. to **522** ft., From **SCREEN 500** ft. to **520** ft.

6 GROUT MATERIAL: 1 Neat cement 2 Cement grout 3 Bentonite 4 Other .....  
 Grout Intervals: From **0** ft. to **20** ft., From ..... ft. to ..... ft., From ..... ft. to ..... ft.  
 What is the nearest source of possible contamination:  
 1 Septic tank 4 Lateral lines 7 Pit privy 10 Livestock pens 14 Abandoned water well  
 2 Sewer lines 5 Cess pool 8 Sewage lagoon 11 Fuel storage 15 Oil well/Gas well  
 3 Watertight sewer lines 6 Seepage pit 9 Feedyard 12 Fertilizer storage 16 Other (specify below)  
**CROPLAND-NOTHING**  
**IMMEDIATE VICINITY**  
 Direction from well? How many feet?

FROM	TO	LITHOLOGIC LOG	FROM	TO	PLUGGING INTERVALS
0	300	SURFACE			
300	400	MED. COARSE SAND W/SOFT BLUE CLAY			
400	460	FINE & MED. COARSE SAND			
460	480	BROWN & BLUE CLAY			
480	500	HARD STREAK 'TIGHT SAND'			
500	520	FINE TIGHT SAND			
520	540	HARD & FIRM RED CLAY			

7 CONTRACTOR'S OR LANDOWNER'S CERTIFICATION: This water well was (1) constructed, (2) reconstructed, or (3) plugged under my jurisdiction and was completed on (mo/day/year) **6/18/92** and this record is true to the best of my knowledge and belief. Kansas Water Well Contractor's License No. **225** This Water Well Record was completed on (mo/day/yr) **7/6/92** under the business name of **KIM DRILLING, INC.** by (signature) *[Signature]*

OFFICE USE ONLY

T

R

EW

SEC.

1/4

1/4

1/4