


1 LOCATION OF WATER WELL: Fraction $\frac{1}{4}$ NW $\frac{1}{4}$ NE $\frac{1}{4}$ Section Number 12 Township Number T 32 S Range Number R 35 EW

Distance and direction from nearest town or city street address of well if located within city?
 7 1/2 miles SE of Moscow, KS--

2 WATER WELL OWNER: Mobil Oil Corp. #1 Combes-Nipple Unit
 RR#, St. Address, Box #: P.O. Box 5444 Board of Agriculture, Division of Water Resources
 City, State, ZIP Code: Denver, CO 80217 Application Number: 910323

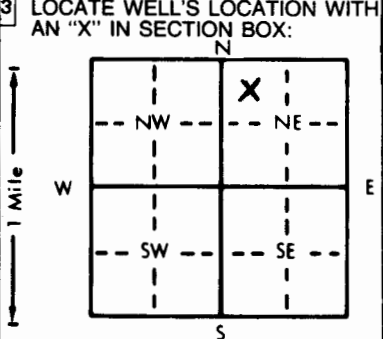

4 DEPTH OF COMPLETED WELL... 380 ft. ELEVATION: ...
 Depth(s) Groundwater Encountered 1... 170 ft. 2... ft. 3... ft.
 WELL'S STATIC WATER LEVEL... 170 ft. below land surface measured on mo/day/yr... 07-22-91
 Pump test data: Well water was... 185 ft. after... 1 hours pumping... 120 gpm
 Est. Yield... 120 gpm: Well water was... ft. after... hours pumping... gpm
 Bore Hole Diameter... 11 in. to... 380 ft., and... in. to... ft.
 WELL WATER TO BE USED AS:
 5 Public water supply 8 Air conditioning 11 Injection well
 1 Domestic 3 Feedlot 6 Oil field water supply 9 Dewatering 12 Other (Specify below)
 2 Irrigation 4 Industrial 7 Lawn and garden only 10 Monitoring well
 Was a chemical/bacteriological sample submitted to Department? Yes... No... X...; If yes, mo/day/yr sample was submitted
 Water Well Disinfected? Yes X No

5 TYPE OF BLANK CASING USED:
 1 Steel 3 RMP (SR) 5 Wrought iron 8 Concrete tile CASING JOINTS: Glued... X... Clamped...
2 PVC 4 ABS 6 Asbestos-Cement 9 Other (specify below) Welded...
 7 Fiberglass Threaded...
 Blank casing diameter... 6 in. to... 380 ft., Dia... in. to... ft., Dia... in. to... ft.
 Casing height above land surface... 24 in., weight... lbs./ft. Wall thickness or gauge No... .032
 TYPE OF SCREEN OR PERFORATION MATERIAL:
 1 Steel 3 Stainless steel 5 Fiberglass 7 PVC 10 Asbestos-cement
 2 Brass 4 Galvanized steel 6 Concrete tile 8 RMP (SR) 11 Other (specify)...
 9 ABS 12 None used (open hole)
 SCREEN OR PERFORATION OPENINGS ARE:
 1 Continuous slot 3 Mill slot 5 Gauzed wrapped 8 Saw cut 11 None (open hole)
 2 Louvered shutter 4 Key punched 6 Wire wrapped 9 Drilled holes
 7 Torch cut 10 Other (specify)...
 SCREEN-PERFORATED INTERVALS: From... 280 ft. to... 380 ft., From... ft. to... ft.
 GRAVEL PACK INTERVALS: From... 180 ft. to... 380 ft., From... ft. to... ft.

6 GROUT MATERIAL: 1 Neat cement 2 Cement grout 3 Bentonite 4 Other... Hole plug
 Grout Intervals: From... 1 ft. to... 20 ft., From... ft. to... ft., From... ft. to... ft.
 What is the nearest source of possible contamination:
 1 Septic tank 4 Lateral lines 7 Pit privy 10 Livestock pens 14 Abandoned water well
 2 Sewer lines 5 Cess pool 8 Sewage lagoon 11 Fuel storage 15 Oil well/Gas well
 3 Watertight sewer lines 6 Seepage pit 9 Feedyard 12 Fertilizer storage 16 Other (specify below)
 13 Insecticide storage
 Direction from well? Northwest How many feet? 175

FROM	TO	LITHOLOGIC LOG	FROM	TO	PLUGGING INTERVALS
0	56	Clay			
56	125	Sand			
125	128	Clay			
128	135	Sand			
135	144	Sandy Clay			
144	164	Clay			
164	187	Sandy Clay			
187	240	Clay			
240	295	Sand and Gravel			
295	298	Clay			
298	340	Sand and Gravel			
340	353	Sandy Clay			
353	366	Sand			
366	380	Clay Red			

7 CONTRACTOR'S OR LANDOWNER'S CERTIFICATION: This water well was 1 constructed, (2) reconstructed, or (3) plugged under my jurisdiction and was completed on (mo/day/year) 07-22-91 and this record is true to the best of my knowledge and belief. Kansas Water Well Contractor's License No. KWWCL-430 This Water Well Record was completed on (mo/day/yr) 07-22-91 under the business name of Howard Drlg. Co. Boc 806 Beaver, OK 73932 by (signature)

INSTRUCTIONS: Use typewriter or ball point pen. PLEASE PRESS FIRMLY and PRINT clearly. Please fill in blanks, underline or circle the correct answers. Send top three copies to Kansas Department of Health and Environment, Bureau of Water, Topeka, Kansas 66620-0001. Telephone: 913-296-5545. Send one to WATER WELL OWNER and retain one for your records.