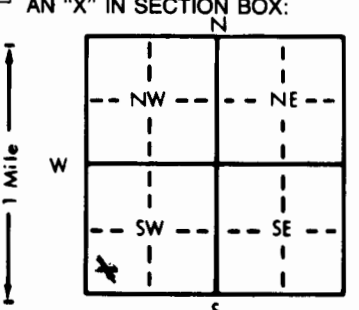


1 LOCATION OF WATER WELL: Fraction NW 1/4 SW 1/4 SW 1/4 Section Number 20 Township Number T 32 S Range Number R 35 EW

Distance and direction from nearest town or city street address of well if located within city? From Woods go 7 mi North 4 mi West 2 mi South 1 mi East and North into location.

2 WATER WELL OWNER: Clifton Brown Mobil Oil Corp.
 RR#, St. Address, Box #: Route #2 West Park Street Board of Agriculture, Division of Water Resources
 City, State, ZIP Code: Dodge City, Kansas Application Number: T 86-232

3 LOCATE WELL'S LOCATION WITH AN "X" IN SECTION BOX:  DEPTH OF COMPLETED WELL: 380 ft. ELEVATION: ... ft.
 Depth(s) Groundwater Encountered 1. 165 ft. 2. ... ft. 3. ... ft.
 WELL'S STATIC WATER LEVEL: 380 ft. below land surface measured on mo/day/yr 6/9/86.
 Pump test data: Well water was ... ft. after ... hours pumping ... gpm
 Est. Yield: 100 gpm: Well water was ... ft. after ... hours pumping ... gpm
 Bore Hole Diameter: 1.1 in. to 380 ft., and ... in. to ... ft.
 WELL WATER TO BE USED AS:
 5 Public water supply 8 Air conditioning 11 Injection well
 1 Domestic 3 Feedlot 6 Oil field water supply 9 Dewatering 12 Other (Specify below)
 2 Irrigation 4 Industrial 7 Lawn and garden only 10 Observation well
 Was a chemical/bacteriological sample submitted to Department? Yes... No...; If yes, mo/day/yr sample was submitted
 Water Well Disinfected? Yes No

5 TYPE OF BLANK CASING USED:
 1 Steel 3 RMP (SR) 5 Wrought iron 8 Concrete tile CASING JOINTS: Glued Clamped
 2 PVC 4 ABS 6 Asbestos-Cement 9 Other (specify below) Welded
 7 Fiberglass Threaded
 Blank casing diameter: 6.5/8 in. to 300 ft., Dia. ... in. to ... ft., Dia. ... in. to ... ft.
 Casing height above land surface: 28 in., weight: 2.85 lbs./ft. Wall thickness or gauge No. 265
 TYPE OF SCREEN OR PERFORATION MATERIAL:
 1 Steel 3 Stainless steel 5 Fiberglass 7 PVC 10 Asbestos-cement
 2 Brass 4 Galvanized steel 6 Concrete tile 8 RMP (SR) 11 Other (specify)
 9 ABS 12 None used (open hole)
 SCREEN OR PERFORATION OPENINGS ARE:
 1 Continuous slot 3 Mill slot 5 Gauzed wrapped 8 Saw cut 11 None (open hole)
 2 Louvered shutter 4 Key punched 6 Wire wrapped 9 Drilled holes
 7 Torch cut 10 Other (specify)
 SCREEN-PERFORATED INTERVALS: From 300 ft. to 380 ft., From ... ft. to ... ft.
 GRAVEL PACK INTERVALS: From 200 ft. to 380 ft., From ... ft. to ... ft.

6 GROUT MATERIAL: 1 Neat cement 2 Cement grout 3 Bentonite 4 Other
 Grout intervals: From 0 ft. to 10 ft., From ... ft. to ... ft., From ... ft. to ... ft.
 What is the nearest source of possible contamination:
 1 Septic tank 4 Lateral lines 7 Pit privy 10 Livestock pens 14 Abandoned water well
 2 Sewer lines 5 Cess pool 8 Sewage lagoon 11 Fuel storage 15 Oil well/Gas well
 3 Watertight sewer lines 6 Seepage pit 9 Feedyard 12 Fertilizer storage 16 Other (specify below)
 13 Insecticide storage

Direction from well? Southeast of water well How many feet? 200'

FROM	TO	LITHOLOGIC LOG	FROM	TO	LITHOLOGIC LOG
0	2	surface			
2	116	clay			
116	144	20% clay & 80% med. to large sand			
144	190	clay			
190	227	med. to large sand			
227	248	20% clay & 65% med. to large sand & 15% gravel			
248	256	55% clay & 45% gravel			
256	272	clay & spots of gravel			
272	366	med. to large sand			
366	380	10% clay & 55% med. to large sand & 35% gravel			

7 CONTRACTOR'S OR LANDOWNER'S CERTIFICATION: This water well was (1) constructed, (2) reconstructed, or (3) plugged under my jurisdiction and was completed on (mo/day/year) June 9, 1986 and this record is true to the best of my knowledge and belief. Kansas Water Well Contractor's License No. 118 This Water Well Record was completed on (mo/day/yr) June 19, 1986 under the business name of Carlile Water Well Service, Inc. by (signature)