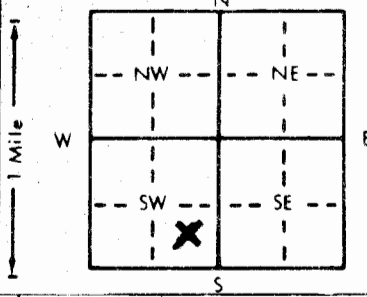


1 LOCATION OF WATER WELL: County: STEVENS Fraction: WC $\frac{1}{4}$ SE $\frac{1}{4}$ SW $\frac{1}{4}$ Section Number: 21 Township Number: T 32S S Range Number: R 35W EW

Distance and direction from nearest town or city street address of well if located within city?
 FROM WOODS: 5 NORTH, 1 1/2 WEST, AND NORTH INTO LOC.

2 WATER WELL OWNER: BEREDCO, INC. #1-21 HAMLIN
 RR#, St. Address, Box #: 401 E. DOUGLAS, #402 Board of Agriculture, Division of Water Resources
 City, State, ZIP Code: WICHITA, KS 67202 Application Number: 930511

3 LOCATE WELL'S LOCATION WITH AN "X" IN SECTION BOX:  4 DEPTH OF COMPLETED WELL: 340 ft. ELEVATION: ...
 Depth(s) Groundwater Encountered 1. 180 ft. 2. ... ft. 3. ... ft.
 WELL'S STATIC WATER LEVEL .180 ft. below land surface measured on mo/day/yr .12-15-93
 Pump test data: Well water was .185 ft. after .1 hours pumping .100 gpm
 Est. Yield .100 gpm: Well water was ... ft. after ... hours pumping ... gpm
 Bore Hole Diameter .11 in. to .340 ft., and ... in. to ... ft.
 WELL WATER TO BE USED AS: 5 Public water supply 8 Air conditioning 11 Injection well
 1 Domestic 3 Feedlot 6 Oil field water supply 9 Dewatering 12 Other (Specify below)
 2 Irrigation 4 Industrial 7 Lawn and garden only 10 Monitoring well
 Was a chemical/bacteriological sample submitted to Department? Yes ... No X ... If yes, mo/day/yr sample was submitted
 Water Well Disinfected? Yes X No

5 TYPE OF BLANK CASING USED: 5 Wrought iron 8 Concrete tile CASING JOINTS: Glued X Clamped ...
 1 Steel 3 RMP (SR) 6 Asbestos-Cement 9 Other (specify below) Welded ...
 2 PVC 4 ABS 7 Fiberglass Threaded ...
 Blank casing diameter .6 in. to .340 ft., Dia . in. to . ft., Dia . in. to . ft.
 Casing height above land surface .24 in., weight .2.902 lbs./ft. Wall thickness or gauge No. .316
 TYPE OF SCREEN OR PERFORATION MATERIAL: 7 PVC 10 Asbestos-cement
 1 Steel 3 Stainless steel 5 Fiberglass 8 RMP (SR) 11 Other (specify) ...
 2 Brass 4 Galvanized steel 6 Concrete tile 9 ABS 12 None used (open hole)
 SCREEN OR PERFORATION OPENINGS ARE: 5 Gauzed wrapped 8 Saw cut 11 None (open hole)
 1 Continuous slot 3 Mill slot 6 Wire wrapped 9 Drilled holes
 2 Louvered shutter 4 Key punched 7 Torch cut 10 Other (specify) ...
 SCREEN-PERFORATED INTERVALS: From .230 ft. to .340 ft., From . ft. to . ft.
 From . ft. to . ft., From . ft. to . ft.
 GRAVEL PACK INTERVALS: From .180 ft. to .340 ft., From . ft. to . ft.
 From . ft. to . ft., From . ft. to . ft.

6 GROUT MATERIAL: 1 Heat cement 2 Cement grout 3 Bentonite 4 Other HOLE PLUG ...
 Grout Intervals: From .1 ft. to .20 ft., From . ft. to . ft., From . ft. to . ft.
 What is the nearest source of possible contamination: 10 Livestock pens 14 Abandoned water well
 1 Septic tank 4 Lateral lines 7 Pit privy 11 Fuel storage 15 Oil well/Gas well
 2 Sewer lines 5 Cess pool 8 Sewage lagoon 12 Fertilizer storage 16 Other (specify below)
 3 Watertight sewer lines 6 Seepage pit 9 Feedyard 13 Insecticide storage
 Direction from well? WEST How many feet? 120

FROM	TO	LITHOLOGIC LOG	FROM	TO	PLUGGING INTERVALS
0	10	TOP SOIL & FINE SAND			
10	52	CALICHE & SANDY CLAY			
52	70	FINE SAND			
70	170	SANDY CLAY			
170	214	FINE TO COARSE SAND & GRAVEL			
214	225	SANDY CLAY			
225	335	FINE TO COARSE SAND & SMALL GRAVEL			
335	340	RED & BLUE CLAY			

7 CONTRACTOR'S OR LANDOWNER'S CERTIFICATION: This water well was (1) constructed, (2) reconstructed, or (3) plugged under my jurisdiction and was completed on (mo/day/year) .12-15-93 and this record is true to the best of my knowledge and belief. Kansas Water Well Contractor's License No. .KWWCL-430 This Water Well Record was completed on (mo/day/yr) .12-15-93 under the business name of HOWARD DRIG. CO. BOX 806 BEAVER, OK 73932 by (signature) *Howard Drig*

INSTRUCTIONS: Use typewriter or ball point pen. PLEASE PRESS FIRMLY and PRINT clearly. Please fill in blanks, underline or circle the correct answers. Send top three copies to Kansas Department of Health and Environment, Bureau of Water, Topeka, Kansas 66620-0001. Telephone: 913-296-5545. Send one to WATER WELL OWNER and retain one for your records.