


USE TYPEWRITER OR BALL POINT PEN-PRESS FIRMLY, PRINT CLEARLY.

WATER WELL RECORD
KSA 82a-1201-1215

Kansas Department of Health and Environment-Division of Environment (Water well Contractors) Topeka, Kansas 66620

1. Location of well:	County Stevens	Fraction NE 1/4 NE 1/4 NW 1/4	Section number 24	Township number T 32 S R 35	Range number E/W
----------------------	--------------------------	---	-----------------------------	---------------------------------------	----------------------------

2. Distance and direction from nearest town or city: Street address of well location if in city:	14 Miles E & 6 miles N of Hugoton	3. Owner of well: R.R. or street: City, state, zip code:	Sam Pittman R.R. Moscow, Kansas 67952
---	--	--	--

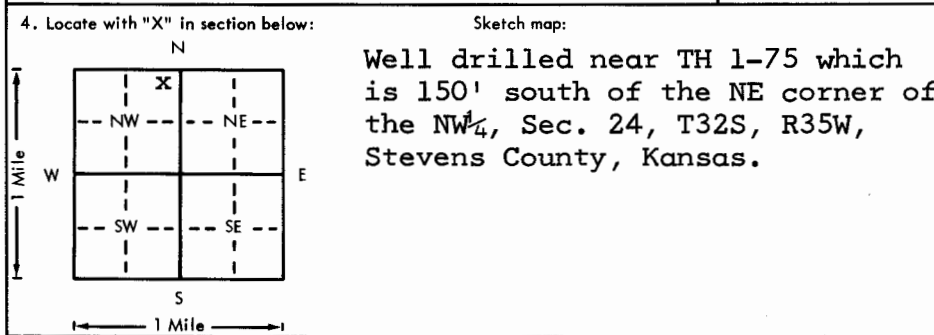

6. Bore hole dia. 28 in. Completion date 11-10-75 Well depth 438 ft.
7. Cable tool <input type="checkbox"/> Rotary <input type="checkbox"/> Driven <input type="checkbox"/> Dug Hollow rod <input type="checkbox"/> Jetted <input type="checkbox"/> Bored <input checked="" type="checkbox"/> Reverse rotary
8. Use: Domestic <input type="checkbox"/> Public supply <input type="checkbox"/> Industry <input checked="" type="checkbox"/> Irrigation Air conditioning <input type="checkbox"/> Stock Lawn <input type="checkbox"/> Oil field water <input type="checkbox"/> Other
9. Casing: Material steel Height: Above or below Threaded <input type="checkbox"/> Welded <input checked="" type="checkbox"/> Surface 12 in. RMP <input type="checkbox"/> PVC <input type="checkbox"/> Weight 39 lbs./ft. Dia. 16 in. to 206 ft. depth Wall Thickness: inches or Dia. <input type="checkbox"/> in. to <input type="checkbox"/> ft. depth gage No. 219

5. Type and color of material	From	To
Top soil	0	2
Tan clay fine sand lenses	2	104
Fine to medium gravel	104	122
Tan clay	122	150
Fine to coarse sand fine gravel to med. Grv.	150	200
F to c sand f to medium gravel lots of clay lenses	200	260
Fine to coarse sand some clay lenses	260	280
Fine to coarse sand lots of clay lenses	280	325
Tan clay sand lenses	325	490
Sandy tan clay	490	519
Red bed	519	540
(Use a second sheet if needed)		

10. Screen: Manufacturer's name Foster & cook Type millslot & Louver Dia. 16" gauge 1/8" Length 232 Set between 206 ft. and 438 ft. ft. and <input type="checkbox"/> ft. Gravel pack? <input checked="" type="checkbox"/> Size range of material 1.8-5 mm
11. Static water level: mo./day/yr. 241 ft. below land surface Date 10-6-75
12. Pumping level below land surfaces: 370 ft. after 1 hrs. pumping 586 g.p.m. ft. after <input type="checkbox"/> hrs. pumping <input type="checkbox"/> g.p.m. Estimated maximum yield 500 g.p.m.
13. Water sample submitted: mo./day/yr. Yes <input type="checkbox"/> No <input checked="" type="checkbox"/> Date <input type="checkbox"/>
14. Well head completion: <input type="checkbox"/> Pitless adapter <input checked="" type="checkbox"/> Inches above grade
15. Well grouted? Yes With: <input type="checkbox"/> Neat cement <input checked="" type="checkbox"/> Bentonite <input type="checkbox"/> Concrete Depth: From 0 ft. to 10 ft.
16. Nearest source of possible contamination: unk ft. <input type="checkbox"/> Direction <input type="checkbox"/> Type <input type="checkbox"/> Well disinfected upon completion? <input checked="" type="checkbox"/> Yes <input type="checkbox"/> No
17. Pump: <input type="checkbox"/> Not installed Manufacturer's name Layne & Bowler Model number 10K HP 90 Volts <input type="checkbox"/> Length of drop pipe 405 ft. capacity 500 g.p.m. Type: <input type="checkbox"/> Submersible <input checked="" type="checkbox"/> Turbine <input type="checkbox"/> Jet <input type="checkbox"/> Reciprocating <input type="checkbox"/> Centrifugal <input type="checkbox"/> Other

18. Elevation:	19. Remarks:
Topography: <input type="checkbox"/> Hill <input type="checkbox"/> Slope <input checked="" type="checkbox"/> Upland <input type="checkbox"/> Valley	

20. Water well contractor's certification: This well was drilled under my jurisdiction and this report is true to the best of my knowledge and belief. Layne-Western Co. Inc. 150 Business name License No. Address Garden City, Ks. Signed [Signature] Date [Signature] Authorized representative
--

32 35 24 NE NE NW
T R S E
1/4 1/4 1/4