


1 LOCATION OF WATER WELL: County: Stevens	Fraction NW 1/4 NW 1/4 SE 1/4	Section Number 25	Township Number T 32 S	Range Number R 35 E/W
---	---	-----------------------------	----------------------------------	---------------------------------

Distance and direction from nearest town or city street address of well if located within city? **From Woods go 2mi East to Seward-Stevens County line 4 1/2 mi North 1/2 mi West to location.**

2 WATER WELL OWNER: **Mrs. Glen Marcellus Mobil Oil Corp.**
 RR#, St. Address, Box # : **924 East 8th Street**
 City, State, ZIP Code : **Liberal, Kansas 67901**
 Board of Agriculture, Division of Water Resources
 Application Number: **T 85-713**

3 LOCATE WELL'S LOCATION WITH AN "X" IN SECTION BOX:

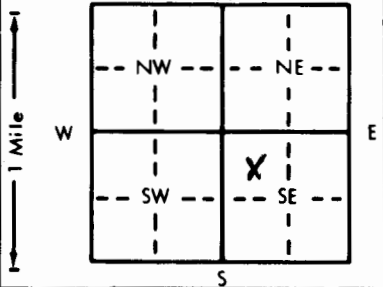

4 DEPTH OF COMPLETED WELL: **507** ft. ELEVATION: _____
 Depth(s) Groundwater Encountered 1. **331** ft. 2. _____ ft. 3. _____ ft.
 WELL'S STATIC WATER LEVEL **176** ft. below land surface measured on mo/day/yr **8/16/85**
 Pump test data: Well water was _____ ft. after _____ hours pumping _____ gpm
 Est. Yield **100** gpm: Well water was _____ ft. after _____ hours pumping _____ gpm
 Bore Hole Diameter **11** in. to **507** ft., and _____ in. to _____ ft.
 WELL WATER TO BE USED AS:
 5 Public water supply 8 Air conditioning 11 Injection well
 1 Domestic 3 Feedlot 6 Oil field water supply 9 Dewatering 12 Other (Specify below)
 2 Irrigation 4 Industrial 7 Lawn and garden only 10 Observation well
 Was a chemical/bacteriological sample submitted to Department? Yes _____ No _____; If yes, mo/day/yr sample was submitted _____
 Water Well Disinfected? Yes _____ No _____

5 TYPE OF BLANK CASING USED:
 1 Steel 3 RMP (SR) 5 Wrought iron 8 Concrete tile CASING JOINTS: Glued _____ Clamped _____
 2 PVC 4 ABS 6 Asbestos-Cement 9 Other (specify below) _____ Welded _____
 7 Fiberglass _____ Threaded _____

Blank casing diameter **6 5/8"** in. to **400** ft., Dia _____ in. to _____ ft., Dia _____ in. to _____ ft.
 Casing height above land surface **28** in., weight **2.85** lbs./ft. Wall thickness or gauge No. **265**

TYPE OF SCREEN OR PERFORATION MATERIAL:
 1 Steel 3 Stainless steel 5 Fiberglass 7 PVC 10 Asbestos-cement
 2 Brass 4 Galvanized steel 6 Concrete tile 8 RMP (SR) 11 Other (specify) _____
 9 ABS 12 None used (open hole)

SCREEN OR PERFORATION OPENINGS ARE:
 1 Continuous slot 3 Mill slot 5 Gauzed wrapped 8 Saw cut 11 None (open hole)
 2 Louvered shutter 4 Key punched 6 Wire wrapped 9 Drilled holes
 7 Torch cut 10 Other (specify) _____

SCREEN-PERFORATED INTERVALS: From **400** ft. to **507** ft., From _____ ft. to _____ ft.
 From _____ ft. to _____ ft., From _____ ft. to _____ ft.
 GRAVEL PACK INTERVALS: From **327** ft. to **507** ft., From _____ ft. to _____ ft.
 From _____ ft. to _____ ft., From _____ ft. to _____ ft.

6 GROUT MATERIAL: 1 Neat cement 2 Cement grout 3 Bentonite 4 Other _____
 Grout Intervals: From **0** ft. to **10** ft., From _____ ft. to _____ ft., From _____ ft. to _____ ft.

What is the nearest source of possible contamination:
 1 Septic tank 4 Lateral lines 7 Pit privy 10 Livestock pens 14 Abandoned water well
 2 Sewer lines 5 Cess pool 8 Sewage lagoon 11 Fuel storage 15 Oil well/Gas well
 3 Watertight sewer lines 6 Seepage pit 9 Feedyard 12 Fertilizer storage 16 Other (specify below)
 13 Insecticide storage

Direction from well? **Southeast of water well** How many feet? **220'**

FROM	TO	LITHOLOGIC LOG	FROM	TO	LITHOLOGIC LOG
0	2	surface			
2	66	clay			
66	102	40% clay & 60% fine sand			
102	131	med. to large sand			
131	144	clay			
144	213	20% clay & 80% med. to large sand			
213	262	clay			
262	283	35% clay & 65% fine sand			
283	413	blue clay			
413	507	60% fine sand with 40% gravel and med. sand			

7 CONTRACTOR'S OR LANDOWNER'S CERTIFICATION: This water well was (1) constructed, (2) reconstructed, or (3) plugged under my jurisdiction and was completed on (mo/day/year) **August 16, 1985** and this record is true to the best of my knowledge and belief. Kansas Water Well Contractor's License No. **118**. This Water Well Record was completed on (mo/day/yr) **August 22, 1985** under the business name of **Carlile Water Well Service, Inc.** by (signature) _____

INSTRUCTIONS: Use typewriter or ball point pen, PLEASE PRESS FIRMLY and PRINT clearly. Please fill in blanks, underline or circle the correct answers. Send top three copies to Kansas Department of Health and Environment, Division of Environment, Environmental Geology Section, Topeka, KS 66620. Send one to WATER WELL OWNER and retain one for your records.