


1 LOCATION OF WATER WELL: County: **Stevens** Fraction: **NW 1/4 NE 1/4 NW 1/4** Section Number: **35** Township Number: **T 32 S** Range Number: **R 35 E/W**

Distance and direction from nearest town or city street address of well if located within city? **From Woods go 3 3/4mi North and 1/2 mi East into location.**

2 WATER WELL OWNER: **Gary Heger Mobil Oil Corp.**  
 RR#, St. Address, Box #: **RFD #1** Board of Agriculture, Division of Water Resources  
 City, State, ZIP Code: **Hugoton, Kansas 67951** Application Number: **T 86-154**

3 LOCATE WELL'S LOCATION WITH AN "X" IN SECTION BOX:

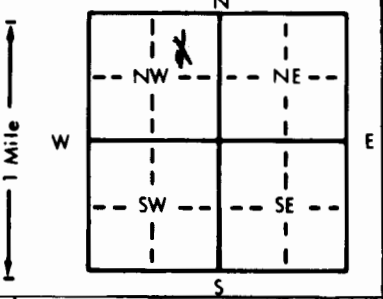

4 DEPTH OF COMPLETED WELL: **400** ft. ELEVATION: ..... ft.  
 Depth(s) Groundwater Encountered 1. **257** ft. 2. .... ft. 3. .... ft.  
 WELL'S STATIC WATER LEVEL **143** ft. below land surface measured on mo/day/yr **4/2/86**  
 Pump test data: Well water was ..... ft. after ..... hours pumping ..... gpm  
 Est. Yield **100** gpm: Well water was ..... ft. after ..... hours pumping ..... gpm  
 Bore Hole Diameter **11** in. to **400** ft., and ..... in. to ..... ft.  
 WELL WATER TO BE USED AS:  
 5 Public water supply 8 Air conditioning 11 Injection well  
 1 Domestic 3 Feedlot 6 Oil field water supply 9 Dewatering 12 Other (Specify below)  
 2 Irrigation 4 Industrial 7 Lawn and garden only 10 Observation well  
 Was a chemical/bacteriological sample submitted to Department? Yes.....No.....; If yes, mo/day/yr sample was submitted  
 Water Well Disinfected? Yes No

5 TYPE OF BLANK CASING USED:  
 1 Steel 3 RMP (SR) 5 Wrought iron 8 Concrete tile CASING JOINTS: Glued ..... Clamped .....  
 2 PVC 4 ABS 6 Asbestos-Cement 9 Other (specify below) Welded .....  
 7 Fiberglass ..... Threaded.....

Blank casing diameter **6 5/8** in. to **260** ft., Dia ..... in. to ..... ft., Dia ..... in. to ..... ft.  
 Casing height above land surface **28** in., weight **2.85** lbs./ft. Wall thickness or gauge No. **265**

TYPE OF SCREEN OR PERFORATION MATERIAL:  
 1 Steel 3 Stainless steel 5 Fiberglass 7 PVC 10 Asbestos-cement  
 2 Brass 4 Galvanized steel 6 Concrete tile 8 RMP (SR) 11 Other (specify) .....  
 9 ABS 12 None used (open hole)

SCREEN OR PERFORATION OPENINGS ARE:  
 1 Continuous slot 3 Mill slot 5 Gauzed wrapped 8 Saw cut 11 None (open hole)  
 2 Louvered shutter 4 Key punched 6 Wire wrapped 9 Drilled holes  
 7 Torch cut 10 Other (specify) .....

SCREEN-PERFORATED INTERVALS: From **200** ft. to **240** ft., From ..... ft. to ..... ft.  
 From **300** ft. to **400** ft., From ..... ft. to ..... ft.

GRAVEL PACK INTERVALS: From **180** ft. to **400** ft., From ..... ft. to ..... ft.  
 From ..... ft. to ..... ft., From ..... ft. to ..... ft.

6 GROUT MATERIAL: 1 Neat cement 2 Cement grout 3 Bentonite 4 Other .....  
 Grout intervals: From **0** ft. to **10** ft., From ..... ft. to ..... ft., From ..... ft. to ..... ft.

What is the nearest source of possible contamination:  
 1 Septic tank 4 Lateral lines 7 Pit privy 10 Livestock pens 14 Abandoned water well  
 2 Sewer lines 5 Cess pool 8 Sewage lagoon 11 Fuel storage 15 Oil well/Gas well  
 3 Watertight sewer lines 6 Seepage pit 9 Feedyard 12 Fertilizer storage 16 Other (specify below)  
 13 Insecticide storage .....

Direction from well? **Southeast of water well** How many feet? **200'**

FROM	TO	LITHOLOGIC LOG	FROM	TO	LITHOLOGIC LOG
0	2	surface			
2	57	clay			
57	76	sandy clay			
76	121	clay			
121	163	40% clay & 60% cemented sand			
163	187	40% clay & 60% med. to large sand with clay			
187	238	20% clay & 80% med. to large sand			
238	317	fine sandw/ med. to large sand			
317	397	med. sand			
397	400	clay			

7 CONTRACTOR'S OR LANDOWNER'S CERTIFICATION: This water well was (1) constructed, (2) reconstructed, or (3) plugged under my jurisdiction and was completed on (mo/day/year) **April 2, 1986** and this record is true to the best of my knowledge and belief. Kansas Water Well Contractor's License No. **118** This Water Well Record was completed on (mo/day/yr) **April 15, 1986** under the business name of **Carlile Water Well Service, Inc.** by (signature) *[Signature]*