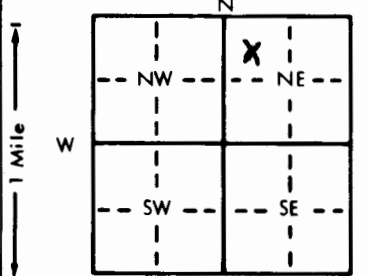


1 LOCATION OF WATER WELL: Fraction 1/4 C-NW 1/4 NE 1/4 Section Number 36 Township Number T 32 S Range Number R 35 EW
 County: Stevens

Distance and direction from nearest town or city street address of well if located within city? From Woods go 2mi East to Seward-Stevens County line 3 7/8mi North 1/2mi West to location.

2 WATER WELL OWNER: Mrs. Glenn Marcellus Mobil Oil Corp.
 RR#, St. Address, Box # : 924 East 8th Street Board of Agriculture, Division of Water Resources
 City, State, ZIP Code : Liberal, Kansas 67901 Application Number: T 84-280

3 LOCATE WELL'S LOCATION WITH AN "X" IN SECTION BOX:

 4 DEPTH OF COMPLETED WELL: 340 ft. ELEVATION:
 Depth(s) Groundwater Encountered 1. 172 ft. 2. ft. 3. ft.
 WELL'S STATIC WATER LEVEL 168 ft. below land surface measured on mo/day/yr 6/12/84
 Pump test data: Well water was ft. after hours pumping gpm
 Est. Yield 60 gpm: Well water was ft. after hours pumping gpm
 Bore Hole Diameter 11 in. to 340 ft., and in. to ft.
 WELL WATER TO BE USED AS:
 5 Public water supply 8 Air conditioning 11 Injection well
 1 Domestic 3 Feedlot 6 Oil field water supply 9 Dewatering 12 Other (Specify below)
 2 Irrigation 4 Industrial 7 Lawn and garden only 10 Observation well
 Was a chemical/bacteriological sample submitted to Department? Yes.....No.....; If yes, mo/day/yr sample was submitted
 Water Well Disinfected? Yes No

5 TYPE OF BLANK CASING USED:
 1 Steel 3 RMP (SR) 5 Wrought iron 8 Concrete tile CASING JOINTS: Glued Clamped
 2 PVC 4 ABS 6 Asbestos-Cement 9 Other (specify below) Welded
 7 Fiberglass Threaded
 Blank casing diameter 6 5/8 in. to 243 ft., Dia in. to ft., Dia in. to ft.
 Casing height above land surface 28 in., weight 2.85 lbs./ft. Wall thickness or gauge No. .265
 TYPE OF SCREEN OR PERFORATION MATERIAL:
 1 Steel 3 Stainless steel 5 Fiberglass 7 PVC 10 Asbestos-cement
 2 Brass 4 Galvanized steel 6 Concrete tile 8 RMP (SR) 11 Other (specify)
 9 ABS 12 None used (open hole)
 SCREEN OR PERFORATION OPENINGS ARE:
 1 Continuous slot 3 Mill slot 5 Gauzed wrapped 8 Saw cut 11 None (open hole)
 2 Louvered shutter 4 Key punched 6 Wire wrapped 9 Drilled holes
 7 Torch cut 10 Other (specify)
 SCREEN-PERFORATED INTERVALS: From 220 ft. to 240 ft., From ft. to ft.
 From 260 ft. to 340 ft., From ft. to ft.
 GRAVEL PACK INTERVALS: From 160 ft. to 340 ft., From ft. to ft.
 From ft. to ft., From ft. to ft.

6 GROUT MATERIAL: 1 Neat cement 2 Cement grout 3 Bentonite 4 Other
 Grout intervals: From 0 ft. to 10 ft., From ft. to ft., From ft. to ft.
 What is the nearest source of possible contamination:
 1 Septic tank 4 Lateral lines 7 Pit privy 10 Livestock pens 14 Abandoned water well
 2 Sewer lines 5 Cess pool 8 Sewage lagoon 11 Fuel storage 15 Oil well/Gas well
 3 Watertight sewer lines 6 Seepage pit 9 Feedyard 12 Fertilizer storage 16 Other (specify below)
 13 Insecticide storage
 Direction from well? Northeast of water well How many feet? 100'

FROM	TO	LITHOLOGIC LOG	FROM	TO	LITHOLOGIC LOG
0	2	01 surface			
2	43	01 sandy clay			
43	78	07 fine sand			
78	145	04 sandy clay			
145	158	07 fine sand			
158	182	04 sandy clay			
182	246	07 fine sand			
246	254	01 blue clay			
254	330	07 fine sand			
330	340	01 blue clay			

7 CONTRACTOR'S OR LANDOWNER'S CERTIFICATION: This water well was (1) constructed, (2) reconstructed, or (3) plugged under my jurisdiction and was completed on (mo/day/year) June 12, 1984 and this record is true to the best of my knowledge and belief. Kansas Water Well Contractor's License No. 118 This Water Well Record was completed on (mo/day/yr) June 28, 1984 under the business name of Carlile Water Well Service, Inc. by (signature) [Signature]

INSTRUCTIONS: Use typewriter or ball point pen, PLEASE PRESS FIRMLY and PRINT clearly. Please fill in blanks, underline or circle the correct answers. Send top three copies to Kansas Department of Health and Environment, Division of Environment, Environmental Geology Section, Topeka, KS 66620. Send one to WATER WELL OWNER and retain one for your records.

OFFICE USE ONLY
T
32
R
35
EWD
SEC.
36
1/4
1/4
1/4
1/4