


1 LOCATION OF WATER WELL: Fraction $\frac{1}{4}$ $\frac{1}{4}$ NE $\frac{1}{4}$ Section Number 16 Township Number T 32 S Range Number R 36 EW

Distance and direction from nearest town or city street address of well if located within city?
 3 MILES SOUTH OF MOSCOW, KS $1\frac{1}{2}$ WEST & SOUTH INTO LOC.

2 WATER WELL OWNER: BEN PERSINGER
 RR#, St. Address, Box #: RT. 1 Board of Agriculture, Division of Water Resources
 City, State, ZIP Code: MOSCOW, KS 67952 Application Number:

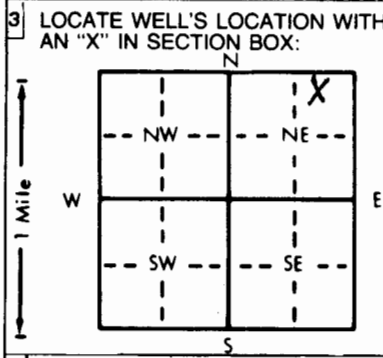

4 DEPTH OF COMPLETED WELL: 420 ft. ELEVATION:
 Depth(s) Groundwater Encountered 1. ft. 2. ft. 3. ft.
 WELL'S STATIC WATER LEVEL ft. below land surface measured on mo/day/yr 12-11-95
 Pump test data: Well water was ft. after 1 hours pumping gpm
 Est. Yield gpm: Well water was ft. after hours pumping gpm
 Bore Hole Diameter. . . 9 1/2 in. to ft., and in. to ft.
 WELL WATER TO BE USED AS: 5 Public water supply 8 Air conditioning 11 Injection well
 1 Domestic 3 Feedlot 6 Oil field water supply 9 Dewatering 12 Other (Specify below)
 2 Irrigation 4 Industrial 7 Lawn and garden only 10 Monitoring well
 Was a chemical/bacteriological sample submitted to Department? Yes No. **X**; If yes, mo/day/yr sample was sub-
 mitted Water Well Disinfected? Yes **X** No

5 TYPE OF BLANK CASING USED: 5 Wrought iron 8 Concrete tile CASING JOINTS: Glued **X** Clamped
 1 Steel 3 RMP (SR) 6 Asbestos-Cement 9 Other (specify below) Welded
 2 **PVC** 4 ABS 7 Fiberglass Threaded
 Blank casing diameter . . . 5 in. to . . . 420 ft., Dia in. to ft., Dia in. to ft.
 Casing height above land surface. . . 24 in., weight . 2.902 lbs./ft. Wall thickness or gauge No. . 280 SDR 21
 TYPE OF SCREEN OR PERFORATION MATERIAL: 7 **PVC** 10 Asbestos-cement
 1 Steel 3 Stainless steel 5 Fiberglass 8 RMP (SR) 11 Other (specify)
 2 Brass 4 Galvanized steel 6 Concrete tile 9 ABS 12 None used (open hole)
 SCREEN OR PERFORATION OPENINGS ARE: 5 Gauzed wrapped 8 **Saw cut** 11 None (open hole)
 1 Continuous slot 3 Mill slot 6 Wire wrapped 9 Drilled holes
 2 Louvered shutter 4 Key punched 7 Torch cut 10 Other (specify)
 SCREEN-PERFORATED INTERVALS: From 200 ft. to . . . 420 ft., From ft. to ft.
 From ft. to ft., From ft. to ft.
 GRAVEL PACK INTERVALS: From 300 ft. to . . . 420 ft., From ft. to ft.
 From ft. to ft., From ft. to ft.

6 GROUT MATERIAL: 1 **Neat cement** 2 Cement grout 3 Bentonite 4 **Other** **HOLE PLUG**
 Grout Intervals: From . . . 0 ft. to . . . 16 ft., From ft. to ft., From ft. to ft.
 What is the nearest source of possible contamination:
 1 Septic tank 4 Lateral lines 7 Pit privy 10 Livestock pens 14 Abandoned water well
 2 Sewer lines 5 Cess pool 8 Sewage lagoon 11 Fuel storage 15 Oil well/Gas well
 3 Watertight sewer lines 6 Seepage pit 9 Feedyard 12 Fertilizer storage 16 Other (specify below)
 13 Insecticide storage
 Direction from well? How many feet?

FROM	TO	LITHOLOGIC LOG	FROM	TO	PLUGGING INTERVALS
0	2	TOP SOIL & SANDY CLAY	280	304	SAND & SANDY CLAY
2	8	SANDY CLAY	304	324	COARSE SAND
8	36	CLAY	324	335	MED GRAVEL W/CLAY STREAKS
36	74	CLAY & SANDY CLAY	335	346	CLAY
74	91	SANDY CLAY	346	375	COARSE SAND
91	106	SAND	375	389	MED. GRAVEL & RED SANDY CLAY
106	152	CLAY & SANDY CLAY	389	397	COARSE SAND & RED SANDY CLAY
152	161	CLAY	397	420	RED SANDY CLAY
161	173	SAND			
173	186	CLAY & SANDY CLAY			
186	200	COARSE SAND W/CLAY STREAKS			
200	224	COARSE SAND			
224	250	CLAY			
250	260	CLAY & SANDY CLAY			
260	280	SANDY CLAY			

7 CONTRACTOR'S OR LANDOWNER'S CERTIFICATION: This water well was (1) constructed, (2) reconstructed, or (3) plugged under my jurisdiction and was completed on (mo/day/year) 12-11-95 and this record is true to the best of my knowledge and belief. Kansas Water Well Contractor's License No. **KWCL-430** This Water Well Record was completed on (mo/day/yr) 12-11-95 under the business name of **HOWARD DR.LG.CO.BOX 806 BEAVER,OK 73932** by (signature)

INSTRUCTIONS: Use typewriter or ball point pen. PLEASE PRESS FIRMLY and PRINT clearly. Please fill in blanks, underline or circle the correct answers. Send top three copies to Kansas Department of Health and Environment, Bureau of Water, Topeka, Kansas 66620-0001. Telephone: 913-296-5545. Send one to WATER WELL OWNER and retain one for your records.