

1 LOCATION OF WATER WELL: | Fraction | Section Number | Township Number | Range Number
 COUNTY: 095 STEVENS | NE 1/4 NE 1/4 NE 1/4 | 21 | T 32 S | R 36 W


Distance and direction from nearest town or city street address of well if located within city?

From Moscow, Approx. 1/2 miles south & 1 mile west.

2 WATER WELL OWNER: MOSS, JIMMY JOE
 RR#, St. Address, Box #: 1003 S ADAMS Board of Agriculture, Division of Water Resources

City, State, ZIP code : HUGOTON, KS 67951-2819 Application Number: 21,392

3 LOCATE WELL'S LOCATION WITH AN "X" IN SECTION BOX: | 4 DEPTH OF COMPLETED WELL 558 ELEVATION: 0
 Depth(s) Groundwater Encountered 1. 0 ft. 2. 0 ft. 3. 0 ft.

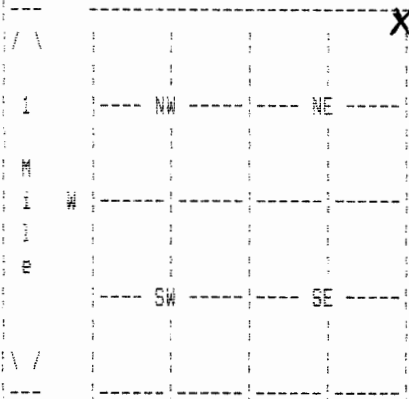

WELL'S STATIC WATER LEVEL 205 ft. below land surface measured on mo/day/yr 04/13/98

Pump test data: Well water was 255 ft. after 4 hours pumping 1000 gpm

Estimated Yield 1000 gpm: Well water was 0 ft. after 0 hours pumping 0 gpm

Bore Hole Diameter 24 in. to 558 ft., and in. to 0 ft.

WELL WATER TO BE USED AS: 02 IRRIGATION

Was a chemical/bacteriological sample submitted to department? No ;

If yes, mo/day/yr sample was submitted Water well disinfected? Yes

5 TYPE OF BLANK CASING USED: 01 STEEL CASING JOINTS: WELDED
 Blank casing diameter 16 in. to 558 ft., Dia in. to 0 ft., Dia in. to 0 ft.
 Casing height above land surface -12 in., weight 42 lbs/ft. Wall thickness or gauge No. .250
 TYPE OF SCREEN OR PERFORATION MATERIAL: 01 STEEL
 SCREEN OR PERFORATION OPENINGS ARE: 01 CONT. SLOT

SCREEN PERFORATED INTERVALS: From 281 ft. to 401 ft., From 0 ft. to 0 ft.
 From 515 ft. to 555 ft., From 0 ft. to 0 ft.
 GRAVEL PACK INTERVALS: From 20 ft. to 558 ft., From 0 ft. to 0 ft.
 From 0 ft. to 0 ft., From 0 ft. to 0 ft.

6 GROUT MATERIAL 03 BENTONITE
 Grout Intervals: From 0 ft. to 20 ft., From 0 ft. to 0 ft., From 0 ft. to 0 ft.
 What is the nearest source of possible contamination: NONE OBSERVED
 Direction from well? How many feet? 0

FROM	TO	LITHOLOGIC LOG	FROM	TO	PLUGGING INTERVALS
0	1	02 SILT			
1	79	04 SANDY CLAY 31 CALICHE 05 SAND			
79	103	07 FINE SAND 08 MEDIUM SAND 09 COARSE SAND			
103	129	05 SAND 11 GRAVEL			
129	145	04 SANDY CLAY			
145	199	04 SANDY CLAY 20 LIMESTONE 05 SAND			
199	262	05 SAND 01 CLAY			
262	280	04 SANDY CLAY 05 SAND			
280	297	05 SAND 11 GRAVEL			
297	342	05 SAND 13 FINE GRAVEL			

7 CONTRACTOR'S OR LANDOWNER'S CERTIFICATION: This water well was Constructed under my jurisdiction and was completed on (mo/day/year) 03/27/98 and this record is true to the best of my knowledge and belief. Kansas Water Well Contractor's License No. 145 This Water Well Record was completed on (mo/day/yr) 04/22/98 under the business name of HENKLE DRILLING & SUPPLY by (signature)

