


1 LOCATION OF WATER WELL. Fraction NW 1/4 SW 1/4 SW 1/4 Section Number 10 Township Number T 32 S Range Number R 36 E
 County: Stevens
 Distance and direction from nearest town or city street address of well if located within city?
From County Intersection of Roads V#19 - .2 mile North

2 WATER WELL OWNER Marlin Neger Board of Agriculture, Division of Water Resources
 RR#, St. Address, Box # 1080 Road 21 Application Number
 City, State, ZIP Code Hugoton, KS 67957

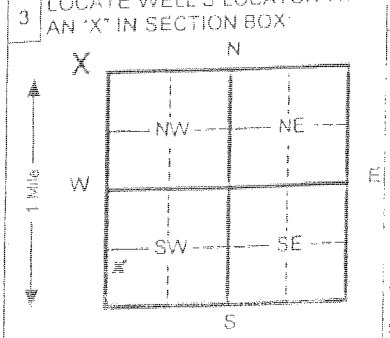

4 DEPTH OF COMPLETED WELL 420 ft. ELEVATION:
 Depth(s) Groundwater Encountered 1 _____ ft. 2 _____ ft. 3 _____ ft.
 WELL'S STATIC WATER LEVEL 304 ft. below land surface measured on (m)day/yr
 Pump test data: Well water was _____ ft. after _____ hours pumping _____ gpm
 Est. Yield _____ gpm Well water was _____ ft. after _____ hours pumping _____ gpm
 Bore Hole Diameter _____ in. to _____ ft. and _____ in. to _____ ft.
 WELL WATER TO BE USED AS:
 1 Domestic 2 Irrigation 3 Feed lot 4 Industrial 5 Public water supply 6 Oil field water supply 7 Lawn and garden (domestic) 8 Air conditioning 9 Dewatering 10 Monitoring well 11 Injection well 12 Other (Specify below)
 Was a chemical/bacteriological sample submitted to Department? Yes _____ No If yes, (m)day/yr sample was submitted _____
 Water Well Disinfected? Yes No _____

5 TYPE OF BLANK CASING USED:
 1 Steel 2 PVC 3 RMP (SR) 4 ABS 5 Wrought Iron 6 Asbestos-Cement 7 Fiberglass 8 Concrete tile 9 Other (specify below)
 Blank casing diameter 16 in. to _____ ft. Dia _____ in. to _____ ft. Dia _____ in. to _____ ft. Dia _____ in. to _____ ft. Dia _____
 Casing height above land surface _____ in. weight _____ lbs./ft. Wall thickness or gauge No. _____
 TYPE OF SCREEN OR PERFORATION MATERIAL:
 1 Steel 2 Brass 3 Stainless steel 4 Galvanized steel 5 Fiberglass 6 Concrete tile 7 PVC 8 RMP (SR) 9 ABS 10 Asbestos-cement 11 Other (specify) 12 None used (open hole)
 SCREEN OR PERFORATION OPENINGS ARE:
 1 Continuous slot 2 Louvered shutter 3 Mill slot 4 Key punched 5 Gauzed wrapped 6 Wire wrapped 7 Torch cut 8 Saw cut 9 Drilled holes 10 Other (specify) 11 None (open hole)
 SCREEN-PERFORATED INTERVALS. From _____ ft. to _____ ft. From _____ ft. to _____ ft. From _____ ft. to _____ ft. From _____ ft. to _____ ft.
 GRAVEL PACK INTERVALS. From _____ ft. to _____ ft. From _____ ft. to _____ ft. From _____ ft. to _____ ft. From _____ ft. to _____ ft.

6 GROUT MATERIAL. 1 Neat cement 2 Cement grout 3 Bentonite 4 Other _____
 Grout Intervals From _____ ft. to _____ ft. From _____ ft. to _____ ft. From _____ ft. to _____ ft. From _____ ft. to _____ ft.
 What is the nearest source of possible contamination:
 1 Septic tank 2 Sewer lines 3 Watertight sewer lines 4 Lateral lines 5 Cess pool 6 Seepage pit 7 Pit privy 8 Sewage lagoon 9 Feedyard 10 Livestock pens 11 Fuel storage 12 Fertilizer storage 13 Insecticide storage 14 Abandoned water well 15 Oil well/ Gas well 16 Other (specify below)
 How many feet? _____

FROM	TO	CODE	LITHOLOGIC LOG	FROM	TO	PLUGGING INTERVALS
				120	240	Gravel Fill
				240	232	Hydrated Bentonite Plug
				232	15	Compacted Soil Fill
				15	4	Cement Plug

7 CONTRACTOR'S OR LANDOWNER'S CERTIFICATION: This water well was (1) constructed, (2) reconstructed, or (3) plugged under my jurisdiction and was _____
 completed on (m)day/yr 5-3-11
 Water Well Contractor's License No. 473
 This Water Well Record was completed on (m)day/yr 5-11-11
 by (signature) [Signature]
 I, the business name of Tyler Water Well Serv by (signature) [Signature]
 INSTRUCTIONS: Please fill in blanks and circle the correct answer. If free space to Kansas Department of Health and Environment, Public Water, 1000
 Telephone: 313-296-6545. Send to WATER WELL OWNER and retain one for your records.