

"CORRECTED"

WATER WELL RECORD Form WWC-5 1304976


Division of Water Resources App. No.

Well ID

- Original Record Correction Change in Well Use

1 LOCATION OF WATER WELL: County: Stevens Fraction SE 1/4 SE 1/4 SE 1/4 SW 1/4 Section Number 29 Township Number T 32 S Range Number R 36 E W

2 WELL OWNER: Last Name: HITTLE First: BILL Barry Street or Rural Address where well is located (if unknown, distance and direction from nearest town or intersection): HUGOTON: INTER OF HWY 51 & HWY 56: N & E ON HWY 56 4.8 MILE TO CR S, E ON CR S 2.75 MILE, N THRU GATE 30', E

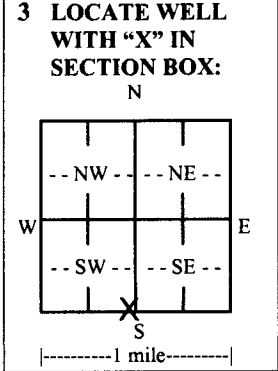

3 LOCATE WELL WITH 'X' IN SECTION BOX: N W E S

4 DEPTH OF COMPLETED WELL: 300 ft. Depth(s) Groundwater Encountered: 1) 185 ft. 2) 232 ft. 3) 248 ft. or 4) Dry Well WELL'S STATIC WATER LEVEL: 185 ft. below land surface, measured on (mo-day-yr) 04/21/2016

5 Latitude: 37.22830 (decimal degrees) Longitude: 101.25771 (decimal degrees) Datum: WGS 84 NAD 83 NAD 27 Source for Latitude/Longitude: GPS (unit make/model) (WAAS enabled? Yes No) Land Survey Topographic Map Online Mapper

6 Elevation: 3090 ft. Ground Level TOC Source: Land Survey GPS Topographic Map Other KOLAR

7 WELL WATER TO BE USED AS: 1. Domestic: Household Lawn & Garden Livestock Irrigation Feedlot Industrial 2. Public Water Supply: well ID Dewatering: how many wells? Aquifer Recharge: well ID Monitoring: well ID Environmental Remediation: well ID Air Sparge Soil Vapor Extraction Recovery Injection Oil Field Water Supply: lease Test Hole: well ID Cased Uncased Geotechnical Geothermal: how many bores? Closed Loop Horizontal Vertical Open Loop Surface Discharge Inj. of Water Other (specify):

Was a chemical/bacteriological sample submitted to KDHE? Yes No If yes, date sample was submitted: Water well disinfected? Yes No

8 TYPE OF CASING USED: Steel PVC Other CASING JOINTS: Glued Clamped Welded Threaded Casing diameter 5 in. to 300 ft., Diameter in. to ft., Diameter in. to ft. Casing height above land surface 24 in. Weight lbs./ft. Wall thickness or gauge No. SDR21 TYPE OF SCREEN OR PERFORATION MATERIAL: Steel Stainless Steel Fiberglass PVC Brass Galvanized Steel Concrete tile None used (open hole) SCREEN OR PERFORATION OPENINGS ARE: Continuous Slot Mill Slot Gauze Wrapped Torch Cut Drilled Holes Other (Specify) Louvered Shutter Key Punched Wire Wrapped Saw Cut None (Open Hole) SCREEN-PERFORATED INTERVALS: From 260 ft. to 300 ft., From ft. to ft., From ft. to ft. GRAVEL PACK INTERVALS: From 130 ft. to 300 ft., From ft. to ft., From ft. to ft.

9 GROUT MATERIAL: Neat cement Cement grout Bentonite Other Grout Intervals: From 0 ft. to 25 ft., From ft. to ft., From ft. to ft. Nearest source of possible contamination: Septic Tank Lateral Lines Pit Privy Livestock Pens Insecticide Storage Sewer Lines Cess Pool Sewage Lagoon Fuel Storage Abandoned Water Well Watertight Sewer Lines Seepage Pit Feedyard Fertilizer Storage Oil Well/Gas Well Other (Specify) Direction from well? Distance from well? ft.

10 FROM	TO	LITHOLOGIC LOG	FROM	TO	LITHO. LOG (cont.) or PLUGGING INTERVALS
0	3	TOP SOIL	173	191	FINE SAND
3	7	SANDY CLAY	191	215	CLAY
7	28	TAN & WHITE CLAY	215	248	CLAY & SAND STRIPS
28	42	BROWN CLAY & SANDY CLAY STRIPS	248	294	SAND
42	87	SANDY CLAY	294	300	RED CLAY & TRACE SANDSTONE
87	93	SANDSTONE & ROCK STRIPS			
93	110	COURSE SAND			
110	126	SAND & CLAY STRIPS			
126	173	CLAY & SAND STRIPS			

11 CONTRACTOR'S OR LANDOWNER'S CERTIFICATION: This water well was constructed, reconstructed, or plugged under my jurisdiction and was completed on (mo-day-year) 04/21/2016 and this record is true to the best of my knowledge and belief. Kansas Water Well Contractor's License No. 430 This Water Well Record was completed on (mo-day-year) 04/25/2016 under the business name of Howard Drilling Co.