


1 LOCATION OF WATER WELL: County: STEVENS	Fraction <input type="checkbox"/> ¼ <input type="checkbox"/> ¼ <input type="checkbox"/> ¼ SW <input type="checkbox"/> ¼	Section Number 6	Township Number T 32 S	Range Number 36 <input type="checkbox"/> E <input checked="" type="checkbox"/> W
--	--	----------------------------	----------------------------------	--

Street/Rural Address of Well Location; if unknown, distance & direction from nearest town or intersection: If at owner's address, check here intersection of RD16 & RDX go 1/2-E approx. 3/4-S & 1/8-W

Global Positioning Systems (GPS) information:
 Latitude: 37.28981 N (in decimal degrees)
 Longitude: 101.27848 W (in decimal degrees)
 Elevation: 3070'
 Horizontal Datum: WGS84, NAD83, NAD27
 Collection Method:

2 WATER WELL OWNER: John Brower
 RR#, St. Address, Box #: **1545 Road X**
 City, State ZIP Code: **Moscow, KS 67952**

GPS unit (Make/Model: GPS Tracks)
 Digital Map/Photo, Topographic Map, Land Survey
 Est. Accuracy: <3 m, 3-5 m, 5-15 m, >15 m

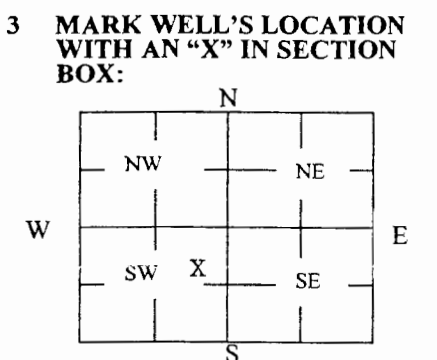

4 DEPTH OF WELL 515 ft.
 WELL'S STATIC WATER LEVEL 346 ft
 WELL WAS USED AS:
 Domestic Public Water Supply Dewatering
 Irrigation Oil Field Water Supply Monitoring
 Feedlot Domestic (Lawn & Garden) Injection Well
 Industrial Air Conditioning Other _____
 Was a chemical/bacteriological sample submitted to Department? Yes No

5 TYPE OF BLANK CASING USED:
 Steel RMP (SR) Wrought Fiberglass Other (Specify below)
 PVC ABS Asbestos-Cement Concrete Tile
 Blank casing diameter 16 in. Was casing pulled? Yes No If yes, how much 48"
 Casing height above or below land surface below 48 in.

6 GROUT PLUG MATERIAL: Neat cement Cement grout Bentonite Other _____
 Grout Plug Intervals: From 4 ft. to 20 ft., From _____ ft. to _____ ft., From _____ ft. to _____ ft.
 What is the nearest source of possible contamination:
 Septic tank Seepage pit Fuel storage Other (specify below)
 Sewer lines Pit privy Fertilizer storage
 Watertight sewer lines Sewage lagoon Insecticide storage
 Lateral lines Feedyard Abandoned water well Direction from well? N
 Cess pool Livestock pens Oil well/Gas well How many feet? 2800

FROM	TO	PLUGGING MATERIALS	FROM	TO	PLUGGING MATERIALS
0'	4'	top soil			
4'	20'	cement			
20'	340'	sand			
340'	515'	chlorinated gravel			

7 CONTRACTOR'S OR LANDOWNER'S CERTIFICATION: This water well was plugged under my jurisdiction and was completed on (mo/day/year) 11-28-2017 and this record is true to the best of my knowledge and belief. Kansas Water Well Contractor's License No. 635. This Water Well Record was completed on (mo/day/year) 11-29-2017 under the business name of L&N Pump, Inc. by (signature) [Signature]

Send one white copy to Kansas Department of Health & Environment, Geology Section, 1000 SW Jackson Street, Ste. 420, Topeka, KS 66612-1367. Send one copy to WATER WELL OWNER and retain one for your records.
 Visit us at <http://www.kdheks.gov/waterwell/index.html> Telephone 785-296-5524.