


1 LOCATION OF WATER WELL: Fraction NW 1/4 NW 1/4 NE 1/4 Section Number 14 Township Number T 32 S Range Number R 36 E

Distance and direction from nearest town or city street address of well if located within city?  
 3 1/2 miles south 1/2 east

2 WATER WELL OWNER: Floyd Tilford  
 RR#, St. Address, Box #: Moscow, Ks 67952  
 City, State, ZIP Code: Moscow, Ks 67952  
 Board of Agriculture, Division of Water Resources  
 Application Number:

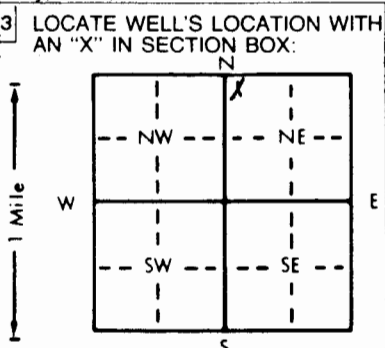

4 DEPTH OF COMPLETED WELL: 475 ft. ELEVATION: Slope  
 Depth(s) Groundwater Encountered 1. 210 ft. 2. ft. 3. ft.  
 WELL'S STATIC WATER LEVEL: 210 ft. below land surface measured on mo/day/yr 4-26-93  
 Pump test data: Well water was ft. after 5 hours pumping 13 gpm  
 Est. Yield 50 gpm: Well water was ft. after hours pumping gpm  
 Bore Hole Diameter 12 1/4 in. to 475 ft., and in. to ft.  
 WELL WATER TO BE USED AS:  
 Domestic 3 Feedlot 6 Oil field water supply 9 Dewatering 12 Other (Specify below)  
 Irrigation 4 Industrial 7 Lawn and garden only 10 Monitoring well  
 Was a chemical/bacteriological sample submitted to Department? Yes No ; If yes, mo/day/yr sample was submitted  
 Water Well Disinfected? Yes  No

5 TYPE OF BLANK CASING USED:  
 Steel 3 RMP (SR) 5 Wrought iron 8 Concrete tile CASING JOINTS: Glued Clamped  
 PVC 4 ABS 6 Asbestos-Cement 9 Other (specify below) Welded   
 Fiberglass Threaded  
 Blank casing diameter 6 5/8 in. to 4.35 ft. Dia in. to ft. Dia in. to ft.  
 Casing height above land surface 18 in. weight 12.92 lbs./ft. Wall thickness or gauge No. 188  
 TYPE OF SCREEN OR PERFORATION MATERIAL:  
 Steel 3 Stainless steel 5 Fiberglass 8 RMP (SR) 11 Other (specify)  
 Brass 4 Galvanized steel 6 Concrete tile 9 ABS 12 None used (open hole)  
 SCREEN OR PERFORATION OPENINGS ARE:  
 1 Continuous slot 3 Mill slot 5 Gauzed wrapped 8 Saw cut 11 None (open hole)  
 2 Louvered shutter 4 Key punched 6 Wire wrapped 9 Drilled holes  
 Torch cut 10 Other (specify)  
 SCREEN-PERFORATED INTERVALS: From 435 ft. to 475 ft. From ft. to ft.  
 GRAVEL PACK INTERVALS: From 24 ft. to 475 ft. From ft. to ft.

6 GROUT MATERIAL: 1 Neat cement 2 Cement grout 3 Bentonite 4 Other  
 Grout Intervals: From 4 ft. to 24 ft. From ft. to ft. From ft. to ft.  
 What is the nearest source of possible contamination:  
 Septic tank 4 Lateral lines 7 Pit privy 10 Livestock pens 14 Abandoned water well  
 Sewer lines 5 Cess pool 8 Sewage lagoon 11 Fuel storage 15 Oil well/Gas well  
 Watertight sewer lines 6 Seepage pit 9 Feedyard 12 Fertilizer storage 16 Other (specify below)  
 Insecticide storage  
 Direction from well? North How many feet? 150 ft.

FROM	TO	LITHOLOGIC LOG	FROM	TO	PLUGGING INTERVALS
0	2	Surface			
2	40	Clay w/ fine sand strips			
40	100	Clay & lime			
100	130	Medium to coarse sand			
130	190	Sandy clay			
190	240	Coarse sand			
240	250	Brown clay			
250	360	Medium to coarse sand			
360	380	Brown clay			
380	477	Medium to coarse sand			

7 CONTRACTOR'S OR LANDOWNER'S CERTIFICATION: This water well was (1)  constructed (2) reconstructed, or (3) plugged under my jurisdiction and was completed on (mo/day/year) 4-26-93 and this record is true to the best of my knowledge and belief. Kansas Water Well Contractor's License No. 164 This Water Well Record was completed on (mo/day/yr) 5-5-93 under the business name of Hauck Bros. Ariz. by (signature) M. Beard