


1 LOCATION OF WATER WELL: County: Stevens Fraction: SW 1/4 SW 1/4 SW 1/4 Section Number: 19 Township Number: T 32 S Range Number: R 36 EW  
 Distance and direction from nearest town or city street address of well if located within city?  
5 miles north and 3 miles east of Hugoton, Ks.

2 WATER WELL OWNER: Matt Wing  
 RR Address, Box #: 304 Jefferson, Hugoton, Ks. 67951 Board of Agriculture, Division of Water Resources  
 City, State, ZIP Code:          Application Number:         

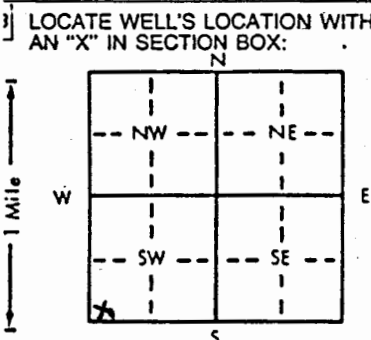

4 DEPTH OF COMPLETED WELL: 2.57 ft. ELEVATION: slope  
 Depth(s) Groundwater Encountered 1. 1.18 ft. 2.          ft. 3.          ft.  
 WELL'S STATIC WATER LEVEL 1.18 ft. below land surface measured on mo/day/yr 12/13/91  
 Pump test data: Well water was 1.28 ft. after 14 hours pumping 1.5 gpm  
 Est. Yield 25 gpm: Well water was          ft. after          hours pumping          gpm  
 Bore Hole Diameter 9.7/8 in. to 1.57 ft., and          in. to          ft.  
 WELL WATER TO BE USED AS:  
 1 Domestic          3 Feedlot          6 Oil field water supply          9 Dewatering          12 Other (Specify below)           
 2 Irrigation          4 Industrial          7 Lawn and garden only          10 Observation well           
 Was a chemical/bacteriological sample submitted to Department? Yes          No X If yes, mo/day/yr sample was submitted           
 Water Well Disinfected? Yes X No         

5 TYPE OF BLANK CASING USED:  
 1 Steel          3 RMP (SR)          5 Wrought iron          8 Concrete tile          CASING JOINTS: Glued X Clamped           
 2 PVC          4 ABS          6 Asbestos-Cement          9 Other (specify below)          Welded           
 7 Fiberglass          Threaded           
 Blank casing diameter 5 in. to 1.57 ft., Dia 5 in. to 2.17 ft., Dia          in. to          ft.  
 Casing height above land surface 1.8 in., weight schedule 200 lbs./ft. Wall thickness or gauge No. SDR-21  
 TYPE OF SCREEN OR PERFORATION MATERIAL:  
 1 Steel          3 Stainless steel          5 Fiberglass          7 PVC          10 Asbestos-cement           
 2 Brass          4 Galvanized steel          6 Concrete tile          8 RMP (SR)          11 Other (specify)           
 9 ABS          12 None used (open hole)           
 SCREEN OR PERFORATION OPENINGS ARE:  
 1 Continuous slot          3 Mill slot          5 Gauzed wrapped          8 Saw cut          11 None (open hole)           
 2 Louvered shutter          4 Key punched          6 Wire wrapped          9 Drilled holes           
 7 Torch cut          10 Other (specify)           
 SCREEN-PERFORATED INTERVALS: From 1.57 ft. to 1.77 ft., From          ft. to          ft.  
 From 2.17 ft. to 2.57 ft., From          ft. to          ft.  
 GRAVEL PACK INTERVALS: From 2.0 ft. to 2.57 ft., From          ft. to          ft.  
 From          ft. to          ft., From          ft. to          ft.

6 GROUT MATERIAL: 1 Neat cement          2 Cement grout          3 Bentonite          4 Other           
 Grout Intervals: From 0 ft. to 2.0 ft., From          ft. to          ft., From          ft. to          ft.  
 What is the nearest source of possible contamination:  
 1 Septic tank          4 Lateral lines          7 Pit privy          10 Livestock pens          14 Abandoned water well           
 2 Sewer lines          5 Cess pool          8 Sewage lagoon          11 Fuel storage          15 Oil well/Gas well           
 3 Watertight sewer lines          6 Seepage pit          9 Feedyard          12 Fertilizer storage          16 Other (specify below)           
 13 Insecticide storage           
 Direction from well? North How many feet? 800

FROM	TO	LITHOLOGIC LOG	FROM	TO	LITHOLOGIC LOG
0	2	Surface			
2	40	Sandy clay			
40	60	Coarse sand			
60	160	Clay & lime shells			
160	180	Medium sand			
180	210	Sandy clay			
210	257	Fine sand			

7 CONTRACTOR'S OR LANDOWNER'S CERTIFICATION: This water well was (1) constructed, (2) reconstructed, or (3) plugged under my jurisdiction and was completed on (mo/day/year) 12-13-91 and this record is true to the best of my knowledge and belief. Kansas Water Well Contractor's License No. 164 This Water Well Record was completed on (mo/day/yr) 5/22/92 under the business name of Houck Bros. Drlg. by (signature) M. Beard

INSTRUCTIONS: Use typewriter or ball point pen, PLEASE PRESS FIRMLY and PRINT clearly. Please fill in blanks, underline or circle the correct answers. Send top three copies to Kansas Department of Health and Environment, Division of Environment, Environmental Geology Section, Topeka, KS 66620. Send one to WATER WELL OWNER and retain one for your records.