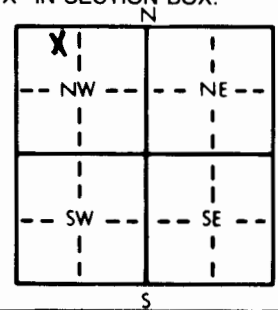


1) LOCATION OF WATER WELL: Fraction NE 1/4 NW 1/4 NW 1/4 Section Number 23 Township Number T 32 S Range Number R 36 E/W
 County: Stevens Distance and direction from nearest town or city street address of well if located within city? From Woods go 6mi West 5 7/8 mi

North 1/2 mi east to location.

2) WATER WELL OWNER: Owen Chaffin Mobil Oil Corp.
 RR#, St. Address, Box # : 2005 East Crescent Dr. Board of Agriculture, Division of Water Resources
 City, State, ZIP Code : Dodge City, Kansas Application Number: T 85-1054

3) LOCATE WELL'S LOCATION WITH AN "X" IN SECTION BOX:

 4) DEPTH OF COMPLETED WELL: 460 ft. ELEVATION:
 Depth(s) Groundwater Encountered 1. 284 ft. 2. ft. 3. ft.
 WELL'S STATIC WATER LEVEL 176 ft. below land surface measured on mo/day/yr 12/12/85
 Pump test data: Well water was ft. after hours pumping gpm
 Est. Yield 100 gpm: Well water was ft. after hours pumping gpm
 Bore Hole Diameter 11 in. to 460 ft., and in. to ft.
 WELL WATER TO BE USED AS: 5 Public water supply 8 Air conditioning 11 Injection well
 1 Domestic 3 Feedlot 6 Oil field water supply 9 Dewatering 12 Other (Specify below)
 2 Irrigation 4 Industrial 7 Lawn and garden only 10 Observation well
 Was a chemical/bacteriological sample submitted to Department? Yes No; If yes, mo/day/yr sample was submitted
 Water Well Disinfected? Yes No

5) TYPE OF BLANK CASING USED:
 1 Steel 3 RMP (SR) 5 Wrought iron 8 Concrete tile CASING JOINTS: Glued Clamped
 2 PVC 4 ABS 6 Asbestos-Cement 9 Other (specify below) Welded
 7 Fiberglass Threaded
 Blank casing diameter 6 5/8 in. to 380 ft., Dia in. to ft., Dia in. to ft.
 Casing height above land surface 28 in., weight 2.85 lbs./ft. Wall thickness or gauge No. 265
 TYPE OF SCREEN OR PERFORATION MATERIAL:
 1 Steel 3 Stainless steel 5 Fiberglass 8 RMP (SR) 10 Asbestos-cement 11 Other (specify)
 2 Brass 4 Galvanized steel 6 Concrete tile 9 ABS 12 None used (open hole)
 SCREEN OR PERFORATION OPENINGS ARE:
 1 Continuous slot 3 Mill slot 5 Gauzed wrapped 8 Saw cut 11 None (open hole)
 2 Louvered shutter 4 Key punched 6 Wire wrapped 9 Drilled holes
 7 Torch cut 10 Other (specify)
 SCREEN-PERFORATED INTERVALS: From 380 ft. to 460 ft., From ft. to ft.
 GRAVEL PACK INTERVALS: From 280 ft. to 460 ft., From ft. to ft.
 From ft. to ft., From ft. to ft.

6) GROUT MATERIAL: 1 Neat cement 2 Cement grout 3 Bentonite 4 Other
 Grout Intervals: From 0 ft. to 10 ft., From ft. to ft., From ft. to ft.
 What is the nearest source of possible contamination:
 1 Septic tank 4 Lateral lines 7 Pit privy 10 Livestock pens 14 Abandoned water well
 2 Sewer lines 5 Cess pool 8 Sewage lagoon 11 Fuel storage 15 Oil well/Gas well
 3 Watertight sewer lines 6 Seepage pit 9 Feedyard 12 Fertilizer storage 16 Other (specify below)
 13 Insecticide storage
 Direction from well? Southwest of water well How many feet? 200'

FROM	TO	LITHOLOGIC LOG	FROM	TO	LITHOLOGIC LOG
0	2	surface			
2	74	clay			
74	122	60% clay & 40% gravel			
122	163	clay			
163	244	med. to large sand			
244	268	35% clay & 65% fine sand			
268	460	fine sand mixed with med. sand			

7) CONTRACTOR'S OR LANDOWNER'S CERTIFICATION: This water well was (1) constructed, (2) reconstructed, or (3) plugged under my jurisdiction and was completed on (mo/day/year) December 12, 1985 and this record is true to the best of my knowledge and belief. Kansas Water Well Contractor's License No. 118 This Water Well Record was completed on (mo/day/yr) December 15, 1985 under the business name of Carlile Water Well Service, Inc. by (signature)

INSTRUCTIONS: Use typewriter or ball point pen, PLEASE PRESS FIRMLY and PRINT clearly. Please fill in blanks, underline or circle the correct answers. Send top three copies to Kansas Department of Health and Environment, Division of Environment, Environmental Geology Section, Topeka, KS 66620. Send one to WATER WELL OWNER and retain one for your records.

OFFICE USE ONLY