


1 LOCATION OF WATER WELL: Fraction NE 1/4 SW 1/4 SW 1/4 Section Number 25 Township Number T 32 S Range Number R 36W EW
 County: Stevens County

Distance and direction from nearest town or city street address of well if located within city? Woods, Kansas - 4 mi. West - 4 1/2 mi North - 3/4 mi. West into location

2 WATER WELL OWNER: Wilbur White Mobil Oil Corp./Unit 19
 RR#, St. Address, Box # : Board of Agriculture, Division of Water Resources
 City, State, ZIP Code : Moscow, Kansas Application Number: T87-549

3 LOCATE WELL'S LOCATION WITH AN "X" IN SECTION BOX:

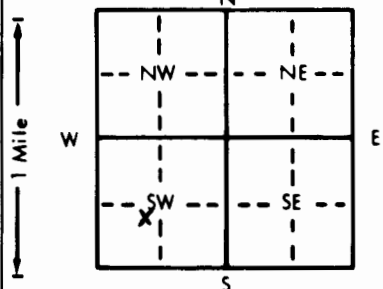

4 DEPTH OF COMPLETED WELL 380 ft. ELEVATION:
 Depth(s) Groundwater Encountered 1. 189 ft. 2. ft. 3. ft.
 WELL'S STATIC WATER LEVEL 189 ft. below land surface measured on mo/day/yr 12/09/87
 Pump test data: Well water was ft. after hours pumping gpm
 Est. Yield 110 gpm: Well water was ft. after hours pumping gpm
 Bore Hole Diameter 11 in. to 380 ft. and in. to ft.
 WELL WATER TO BE USED AS:
 1 Domestic 3 Feedlot 6 Oil field water supply 9 Dewatering 12 Other (Specify below)
 2 Irrigation 4 Industrial 7 Lawn and garden only 10 Observation well
 Was a chemical/bacteriological sample submitted to Department? Yes No X; If yes, mo/day/yr sample was submitted Water Well Disinfected? Yes X No

5 TYPE OF BLANK CASING USED:
 1 Steel 3 RMP (SR) 5 Wrought iron 8 Concrete tile CASING JOINTS: Glued Clamped
 2 PVC 4 ABS 6 Asbestos-Cement 9 Other (specify below) Welded
 7 Fiberglass Threaded

Blank casing diameter 6.625 in. to 260 ft. Dia in. to ft. Dia in. to ft.
 Casing height above land surface 28 in. weight 3.71 lbs./ft. Wall thickness or gauge No. 280

TYPE OF SCREEN OR PERFORATION MATERIAL:
 1 Steel 3 Stainless steel 5 Fiberglass 8 RMP (SR) 10 Asbestos-cement
 2 Brass 4 Galvanized steel 6 Concrete tile 9 ABS 11 Other (specify)
 12 None used (open hole)

SCREEN OR PERFORATION OPENINGS ARE:
 1 Continuous slot 3 Mill slot 5 Gauzed wrapped 8 Saw cut 11 None (open hole)
 2 Louvered shutter 4 Key punched 6 Wire wrapped 9 Drilled holes
 7 Torch cut 10 Other (specify)

SCREEN-PERFORATED INTERVALS: From 260 ft. to 380 ft. From ft. to ft.
 From ft. to ft. From ft. to ft.
 GRAVEL PACK INTERVALS: From 25 ft. to 112 ft. From 120 ft. to 380 ft.
 From ft. to ft. From ft. to ft.

6 GROUT MATERIAL: 1 Neat cement 2 Cement grout 3 Bentonite 4 Other Grout
 Grout Intervals: From 0 ft. to 25 ft. From 112 ft. to 120 ft. From ft. to ft.

What is the nearest source of possible contamination:
 1 Septic tank 4 Lateral lines 7 Pit privy 10 Livestock pens 14 Abandoned water well
 2 Sewer lines 5 Cess pool 8 Sewage lagoon 11 Fuel storage 15 Oil well/Gas well
 3 Watertight sewer lines 6 Seepage pit 9 Feedyard 12 Fertilizer storage 16 Other (specify below)
 13 Insecticide storage
 Direction from well? Northwest How many feet? 195'

FROM	TO	LITHOLOGIC LOG	FROM	TO	LITHOLOGIC LOG
0	2	Surface			
2	18	Sandy Clay			
18	26	Clay			
26	103	Clay-Fine Sand			
103	122	Clay - Med. to large sand			
122	146	80% Clay - 20% Gravel			
146	163	30% Clay - 70% Med. to large sand			
163	208	White Sandy Clay			
208	282	Med. to large sand			
282	293	50% Clay - 50% Gravel			
293	348	Med. to large sand			
348	380	30% Fine Sand - 50% Gravel - 20% Sandy Clay			

7 CONTRACTOR'S OR LANDOWNER'S CERTIFICATION: This water well was (1) constructed (2) reconstructed, or (3) plugged under my jurisdiction and was completed on (mo/day/year) 12/9/87 and this record is true to the best of my knowledge and belief. Kansas Water Well Contractor's License No. 118 This Water Well Record was completed on (mo/day/yr) 12/18/87 under the business name of Carlile Water Well Service, Inc. by (signature)